

Name

William Sullivan

Service No. 6

Address

130 Grove St.
~~56 Pleasant Street~~

Location

LOT 41

Kind of Pipe

Size

Size of Main


~~REPAIR~~ New Service Sibley # 963

Location AUG 5 1968

Date	Material	Amount	Total	Date	Amount
0-3-59	Labor	24 50		3-19-68	55 20
	10% O. H.	2 45	26 95		
20'	6" Transite pipe @ .70		14 00	10-3-59	
2	Hrs. Shovel @ 6.50		13 00	20' 6" Transite	
1	Hr. Trucking		75		
1	Hr. Pump		1 00		
			55 70		
	BILL WHEN CONNECTED				
4-17-68	57' 6" Transite pipe				
	10' 4" Cast Iron pipe				

DATE _____

TOWN OF LEXINGTON — BOARD OF PUBLIC WORKS
SEWER DIVISION

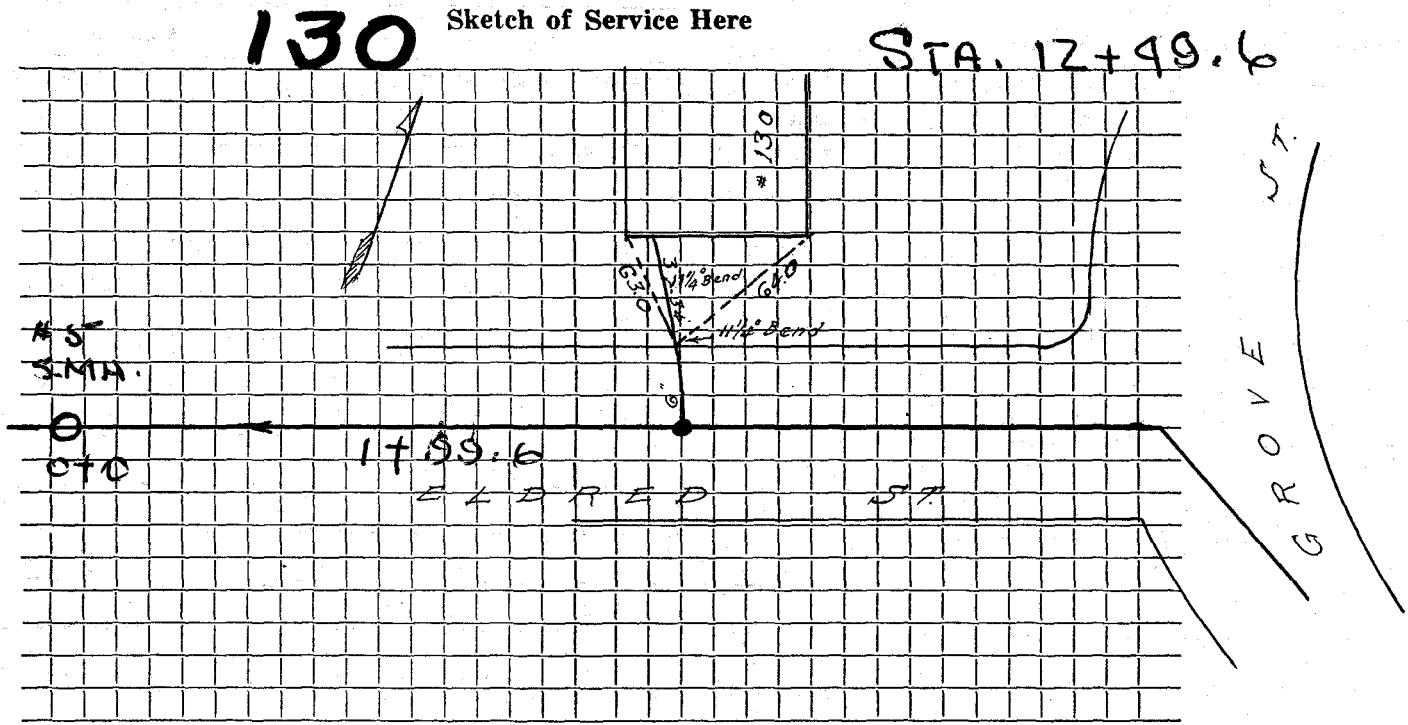

Connection made in Street. Work completed

Remarks:
.....
.....