

Name

Service No.

Address #138 GROVE ST.

Location

Kind of Pipe

Size

Size of Main

Repair—Renewal—New Service

Location

Date	Material	Amount	Total	Date	Amount
12-3-76	120' 6" Transite				
	10' 4" C.I. Pipe				
				11-30-76	
				20' 6" Transite	
				1 6"-1 1/4° Bend	
				1 6"-1 1/4° Elbow	
				1 6" X 8" Wye	


DATE \_\_\_\_\_

TOWN OF LEXINGTON — BOARD OF PUBLIC WORKS

SEWER DIVISION

Sketch of Service Here

138

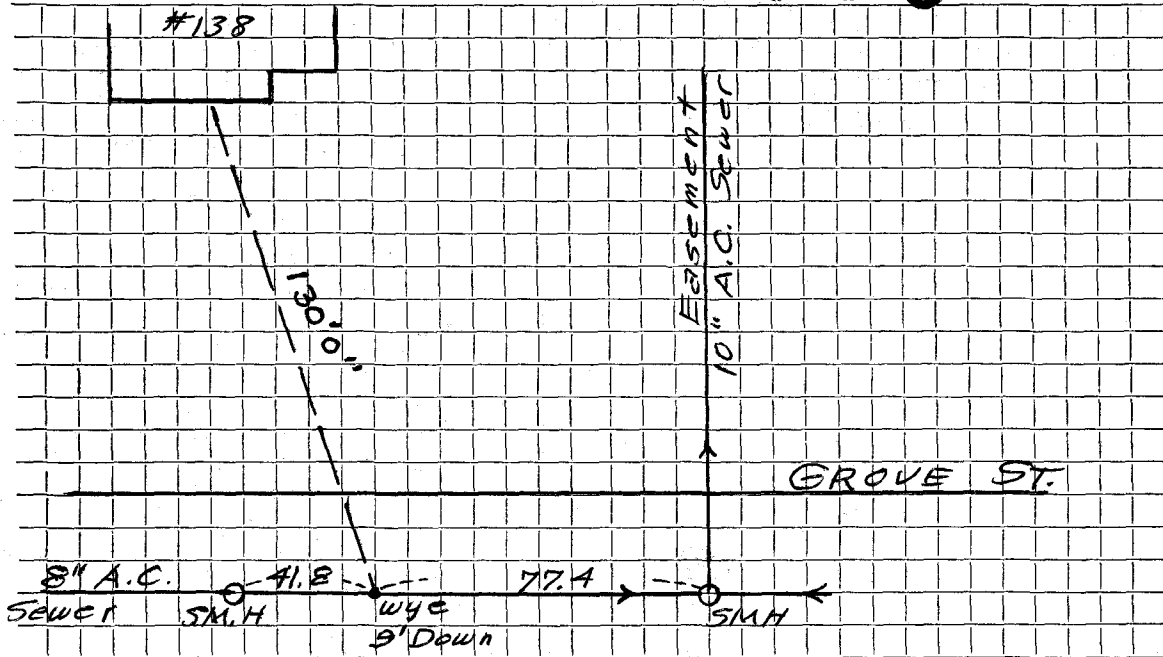

Connection made in ..... Street. Work completed .....

Remarks: .....  
.....  
.....