

Name Ostlund & Bergquist

Service No. 193

Address 139 Grove Street

Location

Kind of Pipe

Size

Size of Main

~~Repair~~ ~~Renewal~~ - New Service

Wo # 7000

Location Comm 2-26-63


Date	Material	Amount	Total	Date	Amount
12/12/61	Labor	40.64		12-1-61	400 00
12/13/61	"	43.54	84 18	2-26-62	134 58
	10% O.H.	8 42	92 60		265 42
	156' 6" Transite Pipe @ .78		121 68		
	1 90° Transite Elbow		5 40		
	1 11½° Transite Elbow		2 24		
	3 Hrs. Town Shovel @ 6.50		19 50	1-25-92	
	1 Hr. Trailer @ 3.00		3 00	John's SEWER 155' OUT	
	2 Hrs. Trucking @ 3.00		6 00	Respond + check r/c. O. by ST.	
	15 X 3 Patch		15 00		
			265 42		

DATE _____

TOWN OF LEXINGTON — BOARD OF PUBLIC WORKS

SEWER DIVISION

139 Sketch of Service Here

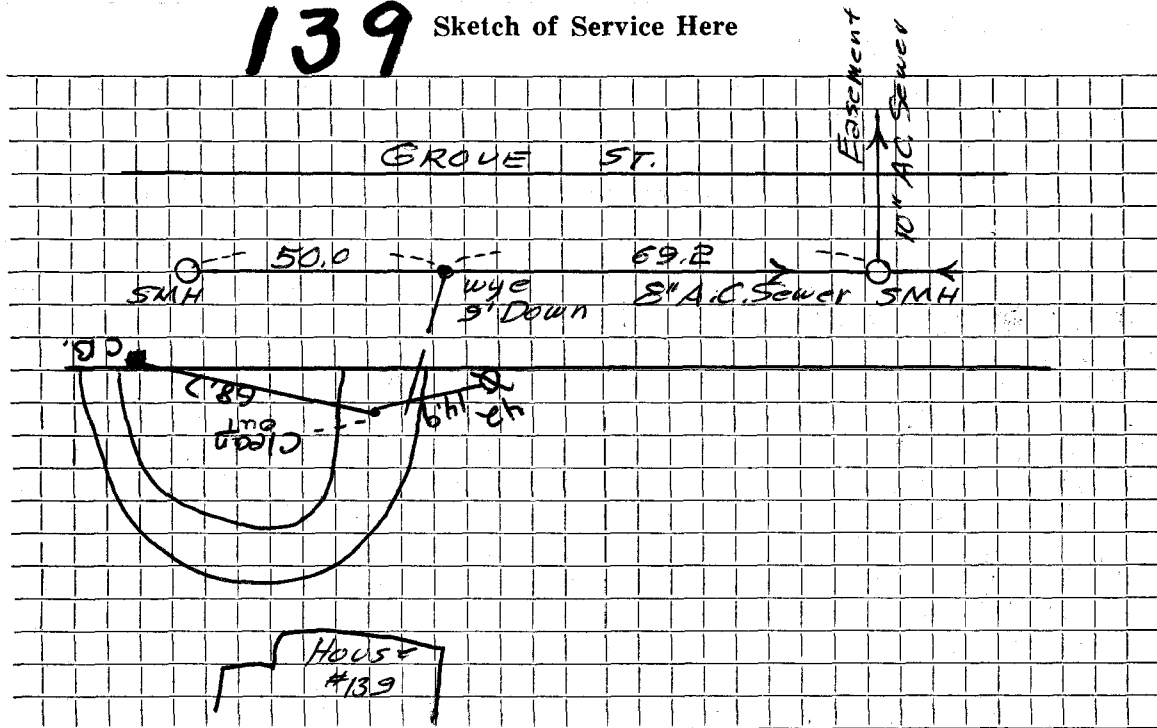

Connection made in Street. Work completed

Remarks: Installed Clean out in drive way... marked by old curb box 5.2" from
Water Shut off PVC clean out 1' deep 1990