

Name Louis Ciampa

Service No. 128

Address 143 Grove Street

Location

Kind of Pipe

Size

Size of Main

~~Repair - Renewal - New Service~~

Location *Comm 12-4-61*


Date	Material	Amount	Total	Date	Amount
10/9/61	Labor 76.68			9-20-61	300 00
10/10/61	" 16.08	92 76		12-4-61	7 26
	10% O.H.	9 28	102 04		207 26
	58' 6" Transite Pipe @ .78		45 24		
	1 6" 22 1/2° Elbows @ 2.24		2 24		
	1 6" 1 1/4" Elbow @ 2.24		2 24		
	3 Hrs. Town Shovel @ 6.50		19 50		
	2 Hrs. Trucking @ 3.00		6 00		
	1 Hrs. Loader @ 3.00		3 00		
	1 Hrs. Trailer @ 3.00		3 00		
	24 x 3 Patch		24 00		
			207 26		

DATE \_\_\_\_\_

TOWN OF LEXINGTON — BOARD OF PUBLIC WORKS

SEWER DIVISION

Sketch of Service Here

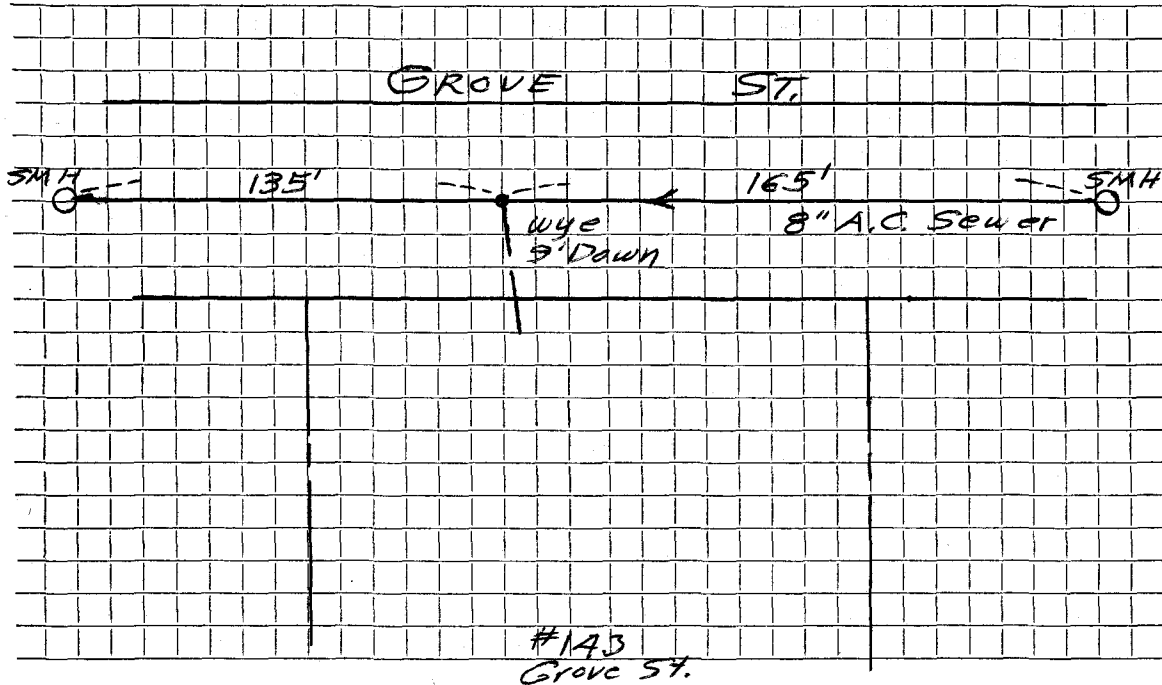

Connection made in ..... Street. Work completed .....

Remarks: .....

.....

.....