

Name Kenneth Walker

Service No. 159

Address #144 GROVE ST.

Location

Kind of Pipe

Size

Size of Main

~~Repair - Renewal - New Service~~ W.O. #9233

Location MAY 17 1965

Date	Material	Amount	Total	Date	Amount
9-24-64	Labor	20.97			
9-25-64	"	72.38			
9-28-64	"	54.84	148.19		
	10% O.H.	14.82	163.01		NON CHARGE
	63' 6" Transite pipe @.82		51.66	9-29-64	Labor 61.80
	1 11 1/2" Transite Bend		4.09		
	1 bag cement		1.50		
	10 x 3 Patch		10.00		
	5 yds Loam @3.00		15.00		
	14 hrs. Town Shovel @6.50		91.00		
	4 hrs. Town Trucking @3.00		12.00		
			348.26		


DATE _____

TOWN OF LEXINGTON — BOARD OF PUBLIC WORKS

SEWER DIVISION

Sketch of Service Here

144

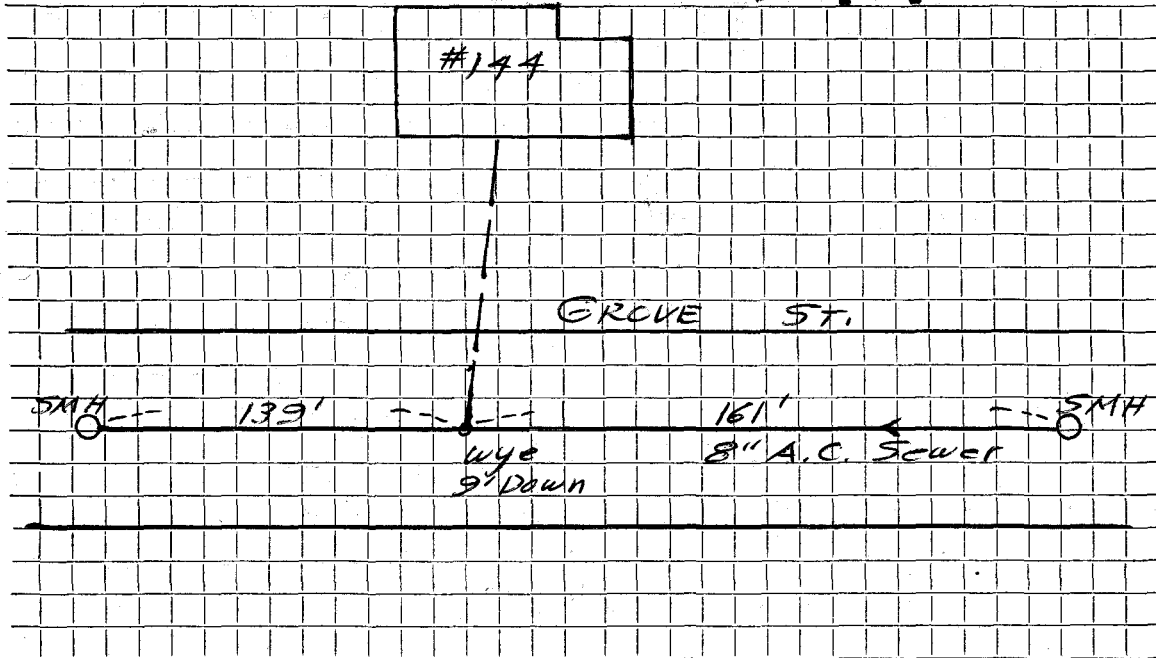

Connection made in Street. Work completed

Remarks:
.....
.....