

Name Michael Smiddy

Service No. 189

Address 145 Grove Street, Lexington, Mass.

Location

Kind of Pipe

Size

Size of Main

~~Repair~~ ~~Renewal~~ — New Service

Location Comm 12-31-61

Date	Material	Amount	Total	Date	Amount
12/12/61	Labor	47 42			
	10% O.H.	<u>4 74</u>	52 16	12-31-61	Deposit 250 00
	56 6" Transite Pipe @ .78		43 68		Returned 93 21
	1 22 $\frac{1}{2}$ " Transite Bend		6 21		<u>156 79</u>
	1 11 $\frac{1}{4}$ " Transite Elbow		2 24		
	3 Hrs. Town Shovel @ 6.50		19 50		
	1 Hr. Trucking @ 3.00		3 00		
	Loam & Seed - Spring		15 00		
	3 X 15 Patch		<u>15 00</u>		
			156 79		


DATE _____

TOWN OF LEXINGTON — BOARD OF PUBLIC WORKS

SEWER DIVISION

Sketch of Service Here

145

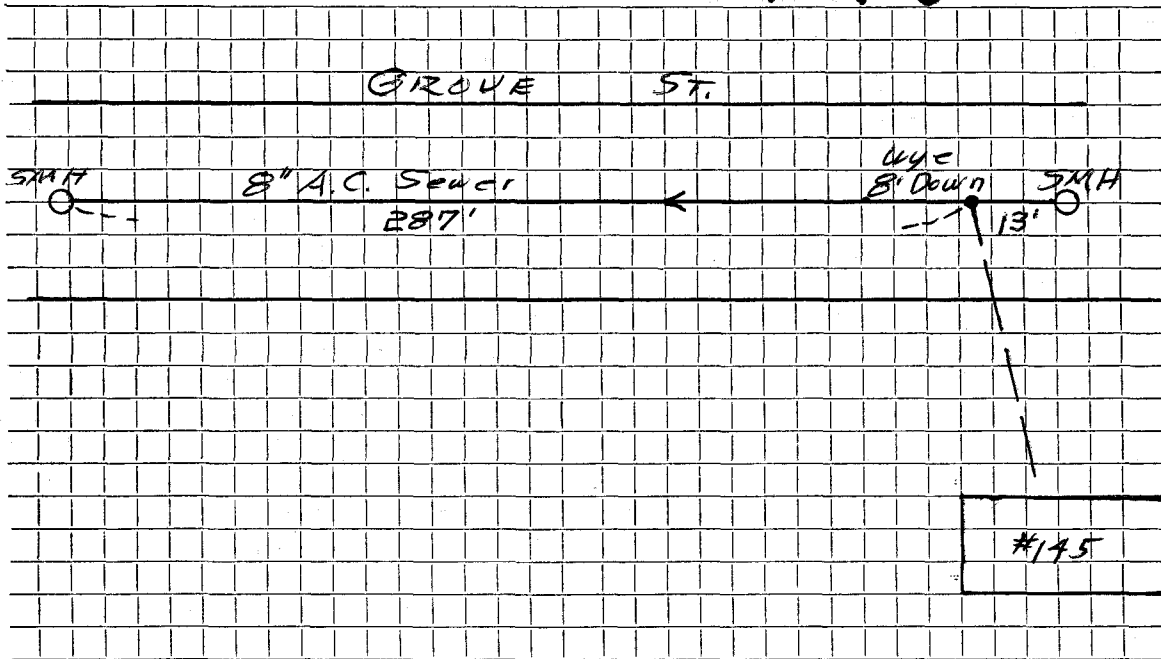

Connection made in Street. Work completed

Remarks:
.....
.....