

Name Ralph E. Pederson

Service No. 174

Address 146 Grove Street

Location

Kind of Pipe

Size

Size of Main

~~Repair - Renewal~~ New Service

Location Comm 12-31-61

Date	Material	Amount	Total	Date	Amount
12/4/61	Labor	93.43		11-17-61	250.00
12/5/61	"	26.70	120 13	1-15-62	21.69
	10% O.H.		12 01		271.69
	58' 6" Transite Pipe @ .78		45 24		
	8 Ton 1 1/2 Stone @ 1.50		12 00		
	1 22 1/2° Transite Bend		6 21		
	1 11 1/4° Transite Elbow		5 10		
	4 Hrs. Town Shovel @ 6.50		26 00		
	3 Hrs. Trucking @ 3.00		9 00		
	2 Hrs. Loader @ 3.00		6 00		
	15 X 3 Patch		15 00		
	Spring- Loam & Seed		15 00		
			271 69		
				Bill sent 21.69	


DATE _____

TOWN OF LEXINGTON — BOARD OF PUBLIC WORKS

SEWER DIVISION

Sketch of Service Here

146

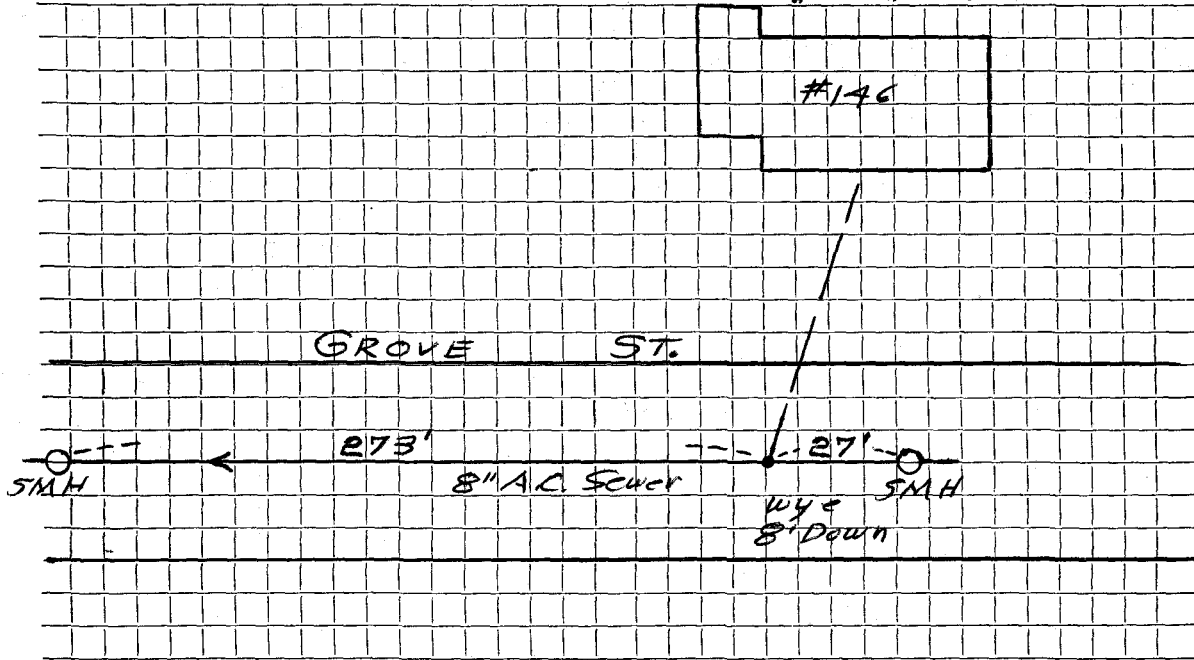

Connection made in Street. Work completed

Remarks:
.....
.....