

Name Soule Bros. Inc.

Service No. 124

Address 153 Grove St.,
(640 Lowell St.,)

Location

Kind of Pipe

Size

Size of Main

~~Repair/Replacement~~ — New Service

Location *Comm 12-4-61*


Date	Material	Amount	Total	Date	Amount
10/7/61	Labor	79 39		9-19-61	Deposit 250 00
10/9/61	"	9 65		12-4-61	Refund 67 84
		89 04			182 16
	10% O.H.	8 90	97 94		
	58' 6" Transite Pipe @ .78		45 24		
	1 22½° Transite Elbow		2 24		
	1 11¼° Transite Elbow		2 24		
	3 Hrs. Town Shovel @ 6.50		19 50		
	4 Hrs. Trucking @ 3.00		12 00		
	1 Hr. Trailer @ 3.00		3 00		
			182 16		

DATE _____

TOWN OF LEXINGTON — BOARD OF PUBLIC WORKS

SEWER DIVISION

Sketch of Service Here

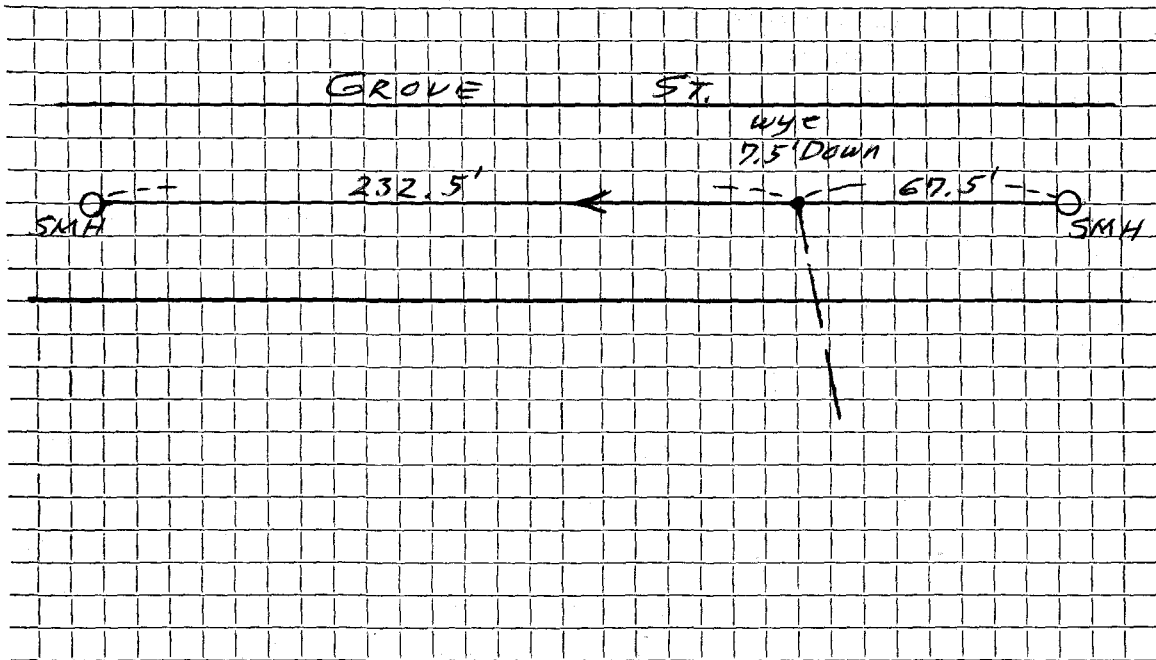

Connection made in Street. Work completed

Remarks:
.....
.....