

Name Spencer Leek

Service No.136

Address 160 Grove Street

Location

Kind of Pipe

Size

Size of Main

~~Repair-Renewal~~ New Service W.O.#7562Location *Comm. 10-29-62*


Date	Material	Amount	Total	Date	Amount
9-4-62	Labor	98.98			
	10% O.H.	9.89	108.87	8-22-62	Deposit 350.00
	60' 6" Transite pipe @82		49.20	10-29-62	ReSund 122.69
	1 90° 6" Transite Elbow		4.09		227.31
	1 8X6 Service Saddle		5.65		
	3 Hrs. Town Shovel @6.50		19.50		
	2 Hrs. Trucking @3.00		6.00		
	15X3 Patch Street		15.00		
	19X3 Patch Driveway		19.00		
			227.31		
				11-19-62	Abate 19.00 - Driveway Patch

DATE _____

TOWN OF LEXINGTON — BOARD OF PUBLIC WORKS
SEWER DIVISION

Sketch of Service Here

160

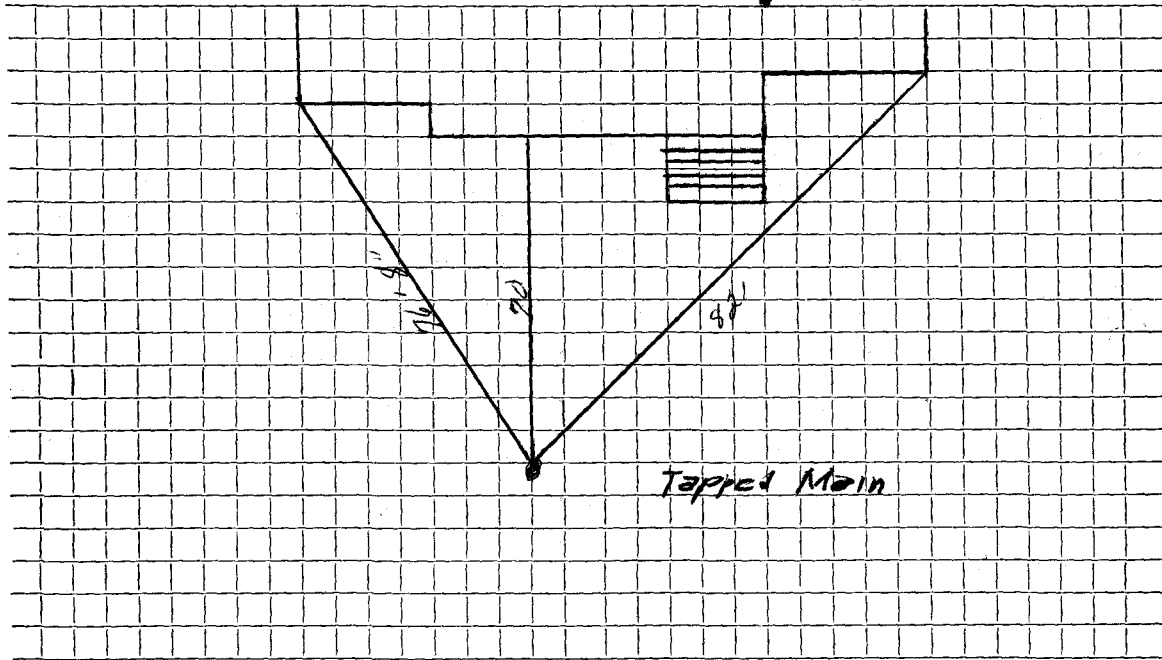

Connection made in Street. Work completed

Remarks: ..90°..Elbow..Saddle..on..Main.....

.....
.....