

Name Robert Wilson

Service No. 164

Address #162 Grove St.

## Location

Kind of Pipe

Size

Size of Main

~~Repair~~ Renewal—New Service Valeri #847 W.O. # 5868

Location

AUG 5 1968


Date	Material	Amount	Total	Date	Amount	
11-15-67	40' 6" Transite pipe			11-13-67	Deposit	135 00
	10' 4" Cast iron pipe			2-12-69	Raid	87 75
12/1/67	Labor	113 89				122 75
12/4/67	Labor	10 63		12-1-67		
	Labor	14 42			22' 6" Transite	
	10% O.H.	13 89	152 83		1 6"-11 1/4° Elbow	
	<del>22' 6" transite @ .88</del>		19 36		1 6"-22 1/2° Elbow	
	<del>1 1 1/4" elbow</del>		2 35		1 Adapter	
	<del>1 22 1/2" elbow</del>		2 35		1 6" X 8" Wye	
	<del>1 adaptor</del>		2 76			
	2 ton hot top @ 5.80		11 60			
	2 hrs trucking @ 3.00		6 00			
	2 hrs. shovel @ 6.50		13 00			
	1 hr. loader		4 00			
	1 hr. compressor		5 00			
	1/2 hr. roller & trailer		3 50			
	TOTAL COST		222 75		Bill sent 787.25	

DATE \_\_\_\_\_

TOWN OF LEXINGTON — BOARD OF PUBLIC WORKS

SEWER DIVISION

Sketch of Service Here **162**

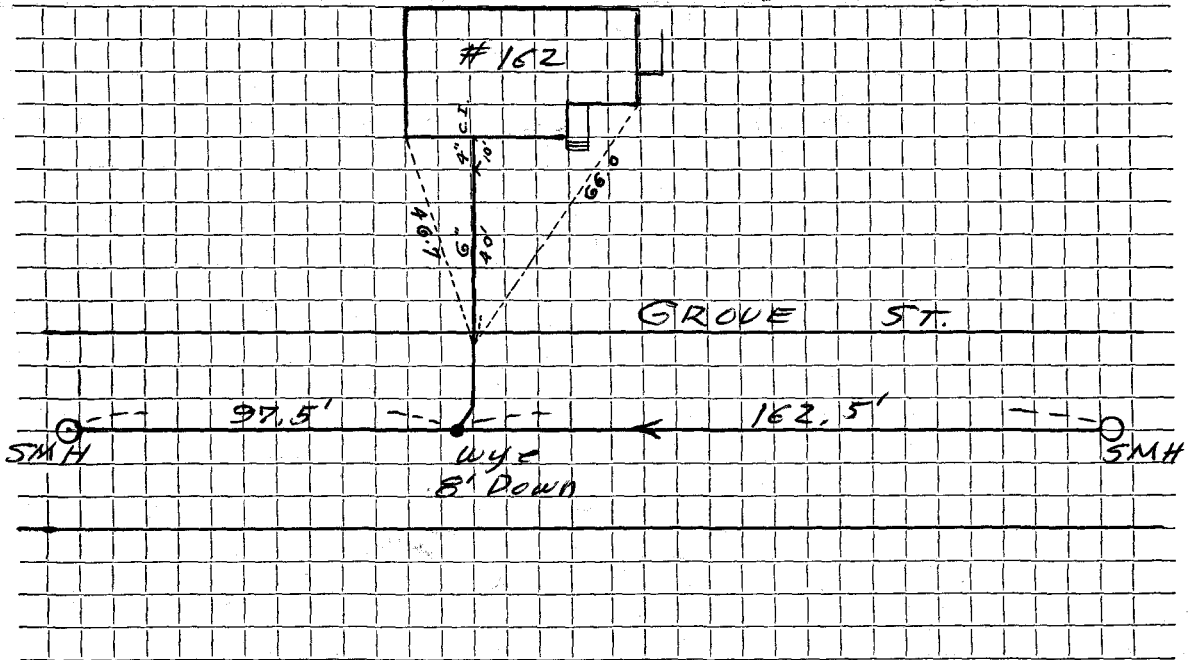

Connection made in ..... Street. Work completed .....

Remarks: .....  
.....  
.....