

Name Richard Hull

Service No. 122

Address 163 Grove Street

Location

Kind of Pipe

Size

Size of Main

~~Repair - Renewal~~ New Service

W.O. #7512

Location

Comm 10-29-62


Date	Material	Amount	Total	Date	Amount
8-31-62	Labor	104.34		8-8-62	Deposit 250.00
	10% O.H.	10.43	114.77	10-29-62	Refund 34.99
	50' 6" Transite pipe @82		41.00		215.01
	1 90° Transite Elbow		4.09		
	1 Service Saddle		5.65		
	3 Hrs. Town Shovel @650		19.50		
	3 Hrs. Trucking @3.00		9.00		
	1 Hr. Trailer @3.00		3.00		
	1 Hr. Loader @3.00		3.00		
	15X3 Patch		15.00		
			215.01		

DATE _____

TOWN OF LEXINGTON — BOARD OF PUBLIC WORKS
SEWER DIVISION

Sketch of Service Here

163

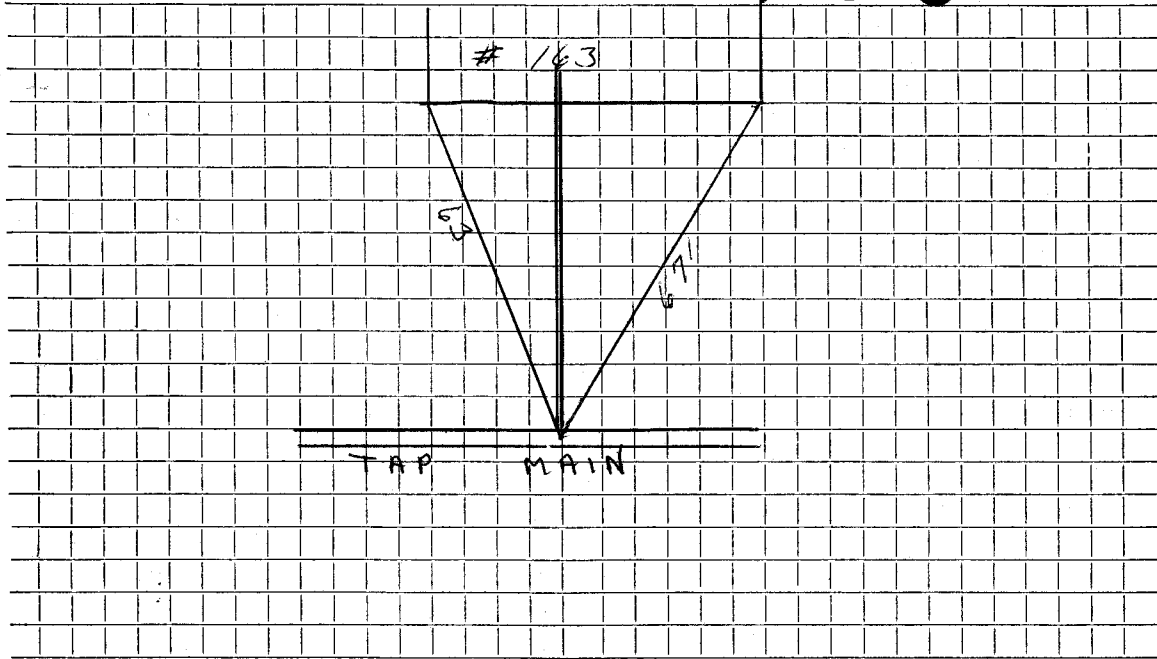

Connection made in Street. Work completed

Remarks:
.....
.....