

Name Mr. Hovarnes Minasian

Service No. 71 (75)

Address 166 Grove Street

Location

Kind of Pipe 6" TRANSITE

Size 6"

Size of Main 8"

~~Repair/Replacement~~ New Service W.O. #3544 Lexington Sewerage Permit #2731

Location NOV 24 1976


Date	Material	Amount	Total	Date	Amount
8-5-75	Labor 122.15			9-30-75	Deposit Paid 3423
8-15-75	" 79.44	\$200.69		12-29-75	
	10% O.H. 20.07		\$220.76		
2	10' Lengths 6" Transite Pipe @1.48		29.60	8-5-75	20' 6" Transite 1 6" x 5' Nipple 1 6"-11 1/4° Bend 1 6"-11 1/4° Elbow 1 6" x 8" C.I Saddle Bill sent 3/4/77
1	5' Lengths 6" " @1.56		7.80		
1	6" x 8" Cast Iron Saddle		20.42		
1	6" Sewer Cap		3.75		
1	11 1/4° Bend		6.76		
1	11 1/4° Collar El		3.84		
4	Hrs. Trucking @3.00		12.00		
3	Hrs. Pickup @1.50		4.50		
2	HRS. Backhoe @6.50		13.00		
1	Hr. Loader		4.00		
1 1/2	Hr. ROLLER @2.00		3.00		
4	Ton Hot Top @13.70		54.80		
1/18/75	75' 6" Transite Pipe		\$384.23		
	8' 4" Cast Iron Pipe				

DATE _____

TOWN OF LEXINGTON — BOARD OF PUBLIC WORKS
SEWER DIVISION

Sketch of Service Here

166

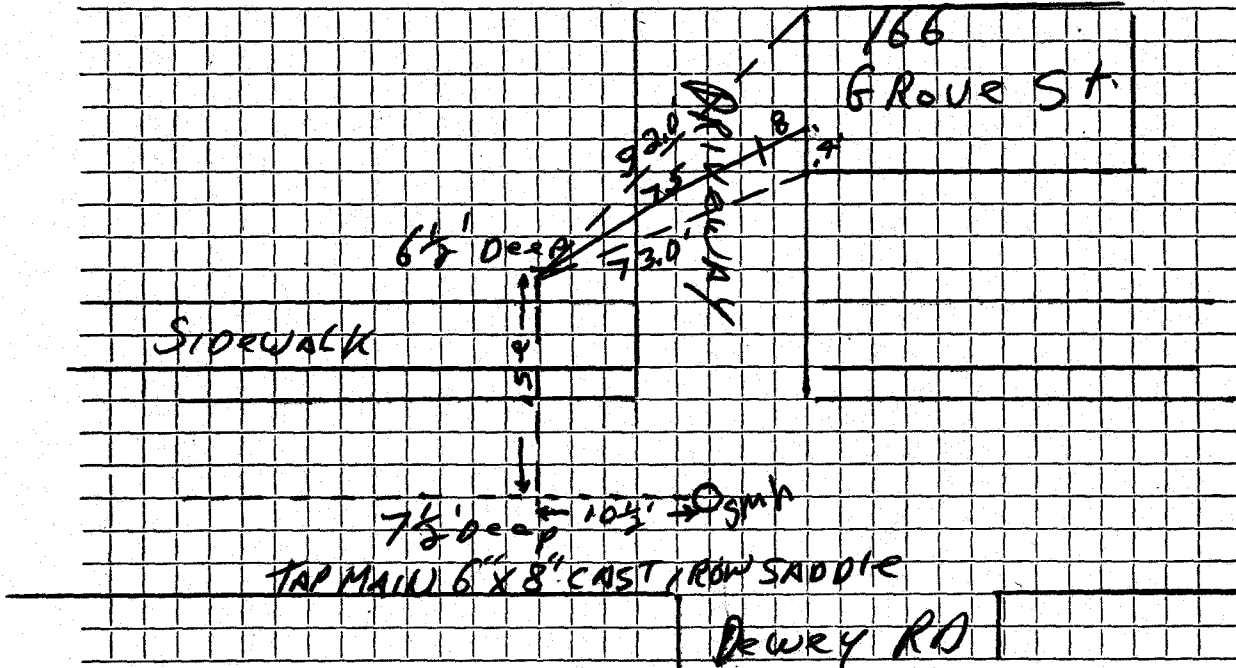

Connection made in Street. Work completed

Remarks:
.....
.....