

Name Bard Crawford

Service No. 196

Address 175 Grove Street

Location

Kind of Pipe

Size

Size of Main

~~REPAIR WORK~~ - New Service Valeri Const. Co. Permit #A-50 W.O.#1145

Location


MAR 14 1966

Date	Material	Amount	Total	Date	Amount
11-2-65	Labor	54 92		10-20-65	Deposit 100 00
	10% O.H.	5 49	60 41	4-21-66	Paid 18 57
20'	6" Transite pipe @ .82		16 40		118 57
1	Elbow		4 09	11-2-65	
	20 x 3 Patch		20 00	20'	6" Transite
1	Hr. Town Truck		3 00	1	6" Elbow
1/3	Hr. Compressor @ 5.00		1 67		
			118 57		
11-4-65	80' 6" Transite pipe				
					Bill sent 18 57

DATE _____

TOWN OF LEXINGTON — BOARD OF PUBLIC WORKS
SEWER DIVISION

Sketch of Service Here **175**

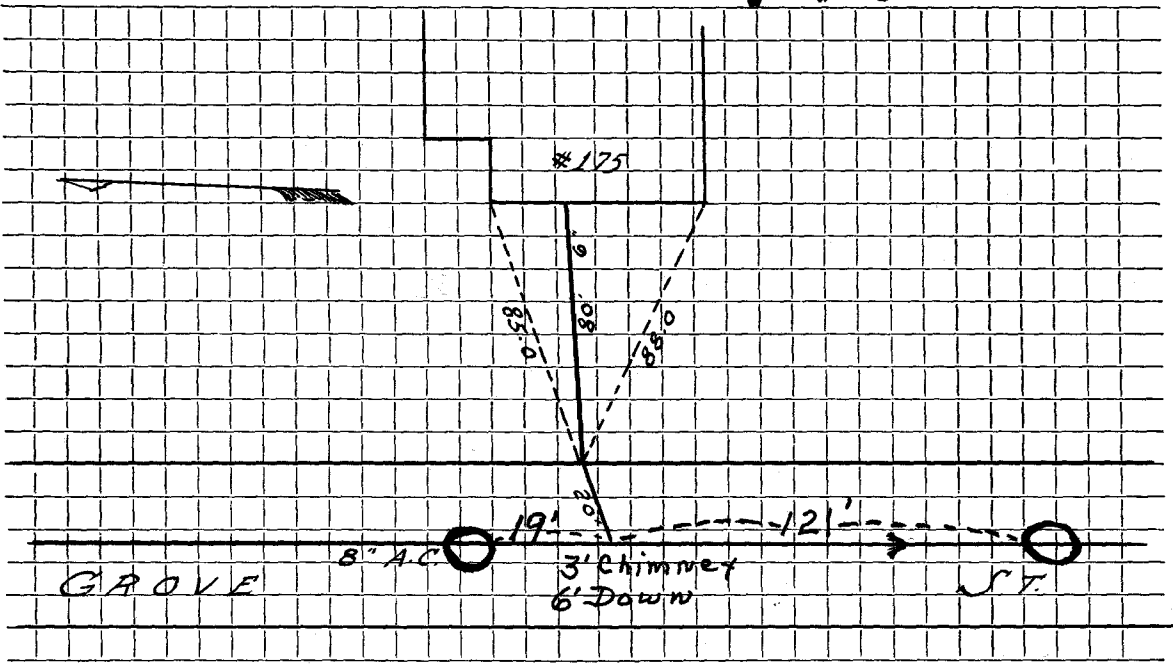

Connection made in Street. Work completed

Remarks:
.....
.....