


DATE _____

TOWN OF LEXINGTON — BOARD OF PUBLIC WORKS

SEWER DIVISION

Sketch of Service Here

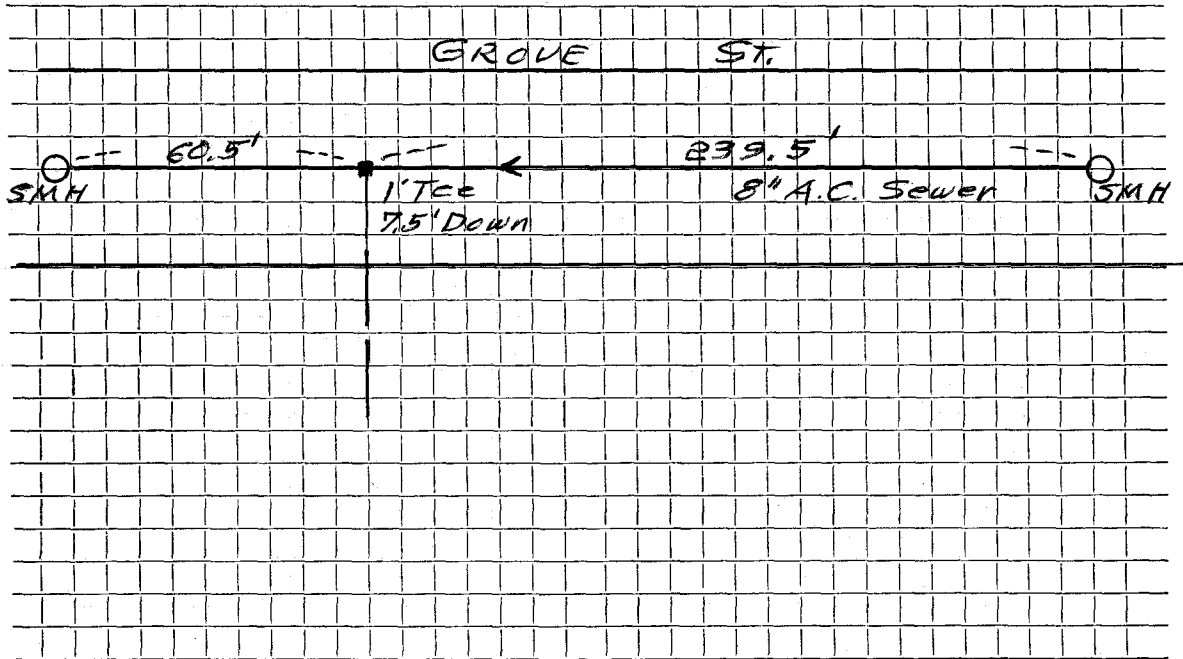

Connection made in Grove St. Street.

Work completed Sept 13, 1985

Remarks:

.....

.....