

Name George W. Anderson

Service No. 157

Address 179 Grove St., Lexington, Mass.

Location

Kind of Pipe

Size

Size of Main

~~Repair~~ ~~Renewal~~ New Service

Location *Cum. 12-31-61*

Date	Material	Amount	Total	Date	Amount
11/15/61	Labor	84 93		10-30-61	200 00
	10% O.H.	8 49	93 42	12-31-61	27 38
	60' 6" Transite Pipe @ .78		46 80		172 62
	1 90° Transite Elbow		5 40		
	2 Hrs. Town Shovel @ 6.50		13 00		
	2 Hrs. Trucking @ 3.00		6 00		
	8 X 3 Patch		8 00		
			172 62		


DATE _____

TOWN OF LEXINGTON — BOARD OF PUBLIC WORKS

SEWER DIVISION

Sketch of Service Here

179

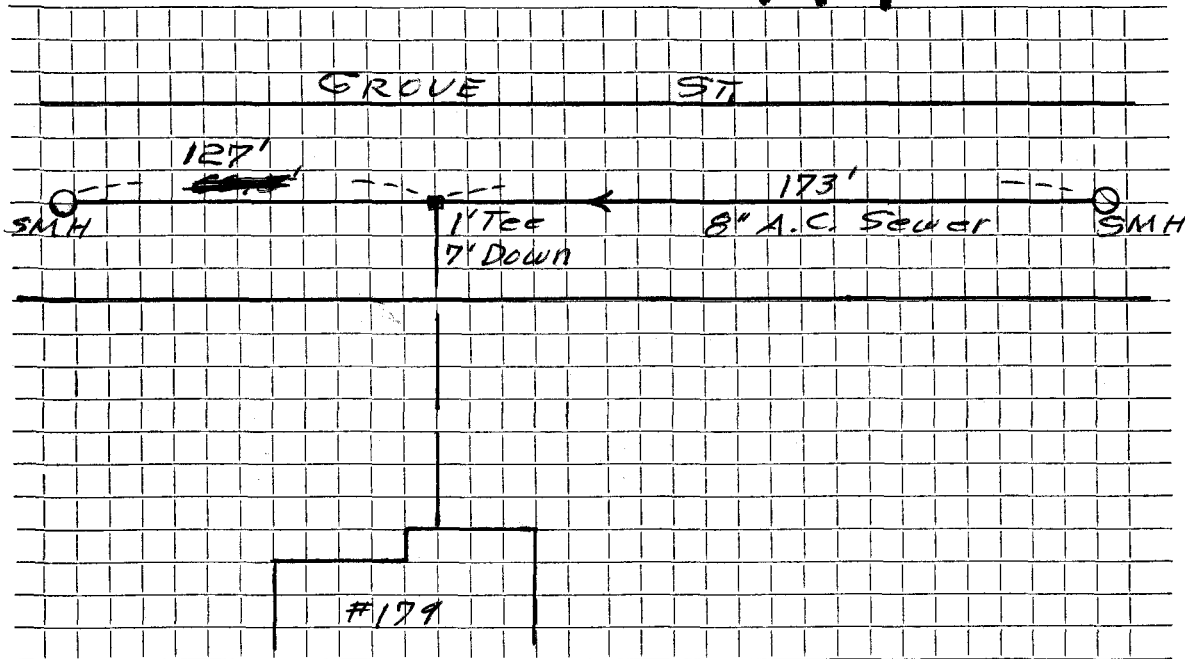

Connection made in Street. Work completed

Remarks:
.....
.....