

Name Ben Franklin Homes

Service No. 130

Address 186 Grove Street

(Mail: P.O.Box 53, Newton 58, Mass.) Location

Kind of Pipe

Size

Size of Main

~~Repair - Renewal~~ New Service


Location Comm 12-4-61

Date	Material	Amount	Total	Date	Amount
10/6/61	Labor	37.41		9-26-61	Deposit 250 00
0/7/61	"	28.95	66 36	12-4-61	Refund 39 60
	10% O.H.	6 64	73 00		210 40
	100' 6" Transite Pipe @ .78		78 00		
	1 6" 90° Transite Elbow @ 5.40		5 40		Non-Charge
	4 Hrs. Town Shovel @ 6.50		26 00	10/7/61	Labor 9 65
	5 Hrs. Trucking @ 3.00		15 00		(Wait for Eng. Dept.)
	1 Hr. Trailer @ 3.00		3 00		
	10 x 3 Patch		10 00		
			210 40		

DATE _____

TOWN OF LEXINGTON — BOARD OF PUBLIC WORKS
SEWER DIVISION

Sketch of Service Here

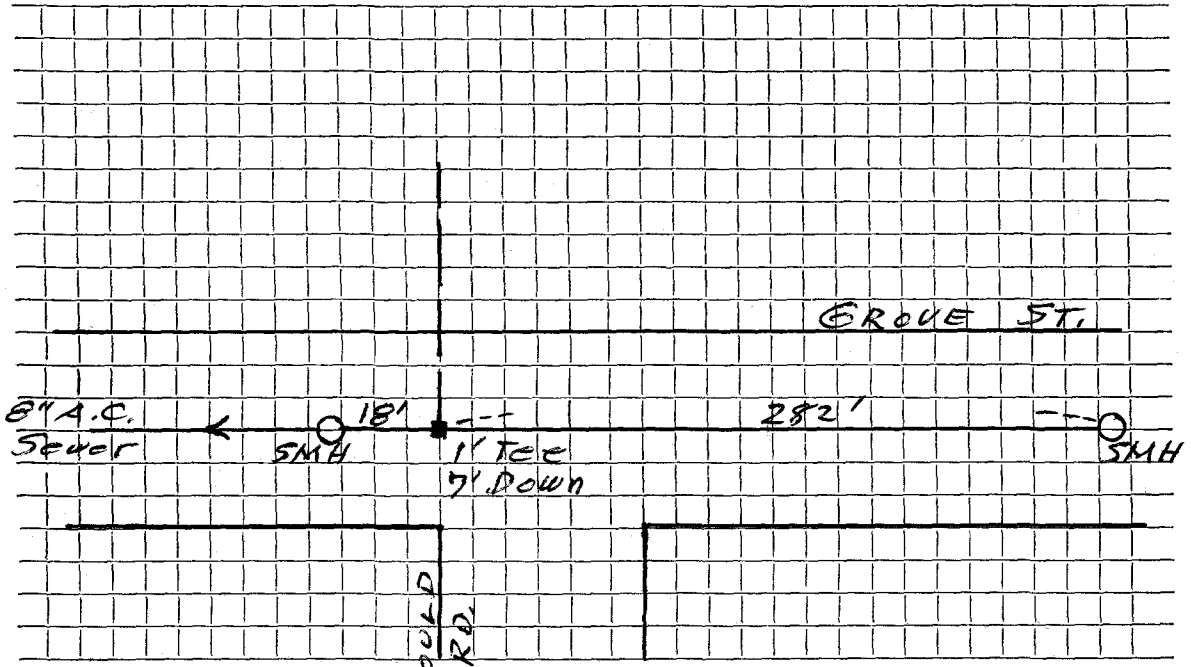

Connection made in Street. Work completed

Remarks:
.....
.....