

Name Mrs. Orrin Brawn

Service No. 81

Address #191 GROVE ST.

Location

Kind of Pipe

Size

Size of Main

~~Repair - Renewal~~ - New Service WO #8056

Location Comm 10-28-63

Date	Material	Amount	Total	Date	Amount
9-9-63	Labor	105.87		7-1-63	350.00
9-10-63	"	24.48	130.35	10-28-63	34.12
	10% O.H.	13.04	143.39		315.88
	95' 6" Transite pipe @.82		77.90		
	1 90° Transite Elbow		4.09		
	3 hrs. Town Shovel @6.50		19.50		
	3 hrs. Trucking @3.00		9.00		
	2 hrs. Loader @5.00		10.00		
	16 x 3 Patch		16.00		
	12 yds. Loam @3.00		36.00		
			315.88		


DATE _____

TOWN OF LEXINGTON — BOARD OF PUBLIC WORKS

SEWER DIVISION

Sketch of Service Here

191

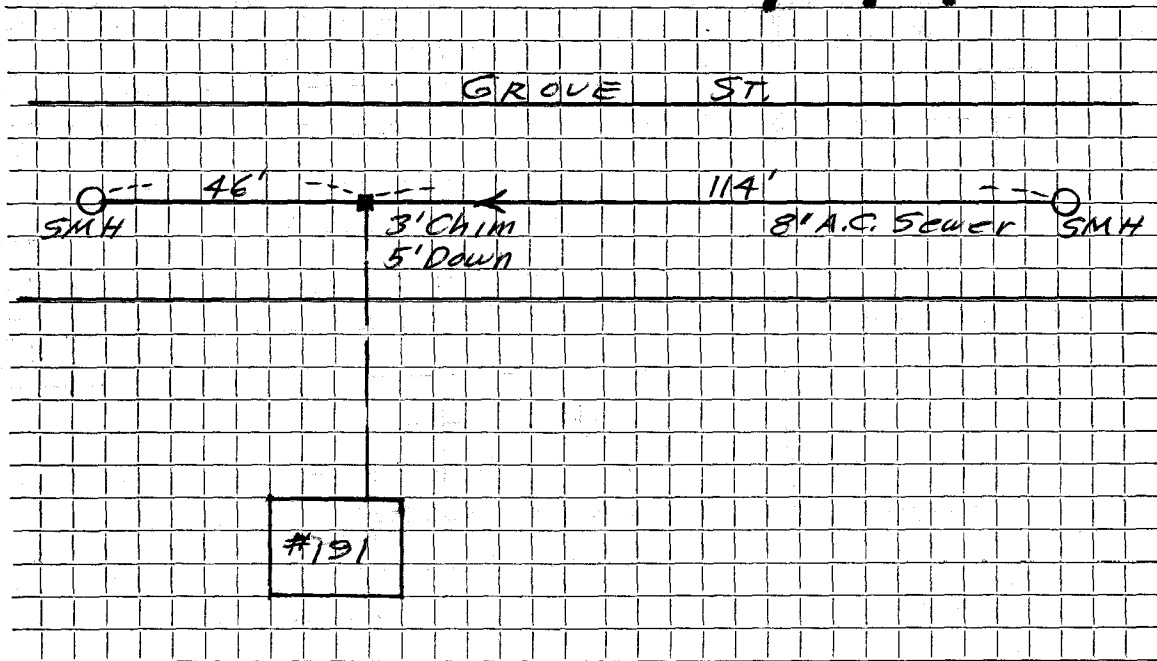

Connection made in Street. Work completed

Remarks:

.....

.....