

Name Edward W. Turner

Service No.

162

Address 195 Grove Street

Location

Kind of Pipe

Size

Size of Main

~~Repair Renewal~~—New Service

Location

Comm 12-18-61

Date	Material	Amount	Total	Date	Amount
11/16/61	Labor	80 95		11-6-61	300 00
11/17/61	"	43 60		12-18-61	32 41
		124 55			267 59
	10% O.H.	12 46	137 01		
	90' 6" Transite Pipe @ .78		70 20		
	1 6" 90° Transite Elbow		5 40		
	2 11 $\frac{1}{4}$ " Transite Elbows @ 2.24		4 48		
	3 Hrs. Town Shovel @ 6.50		19 50		
	4 Hrs. Trucking @ 3.00		12 00		
	1 Hr. Loader @ 3.00		3 00		
	12 X 9 Patch		16 00		
5/11/62			267 59		
	Loom + Seed		15 00		


DATE _____

TOWN OF LEXINGTON — BOARD OF PUBLIC WORKS

SEWER DIVISION

Sketch of Service Here

195

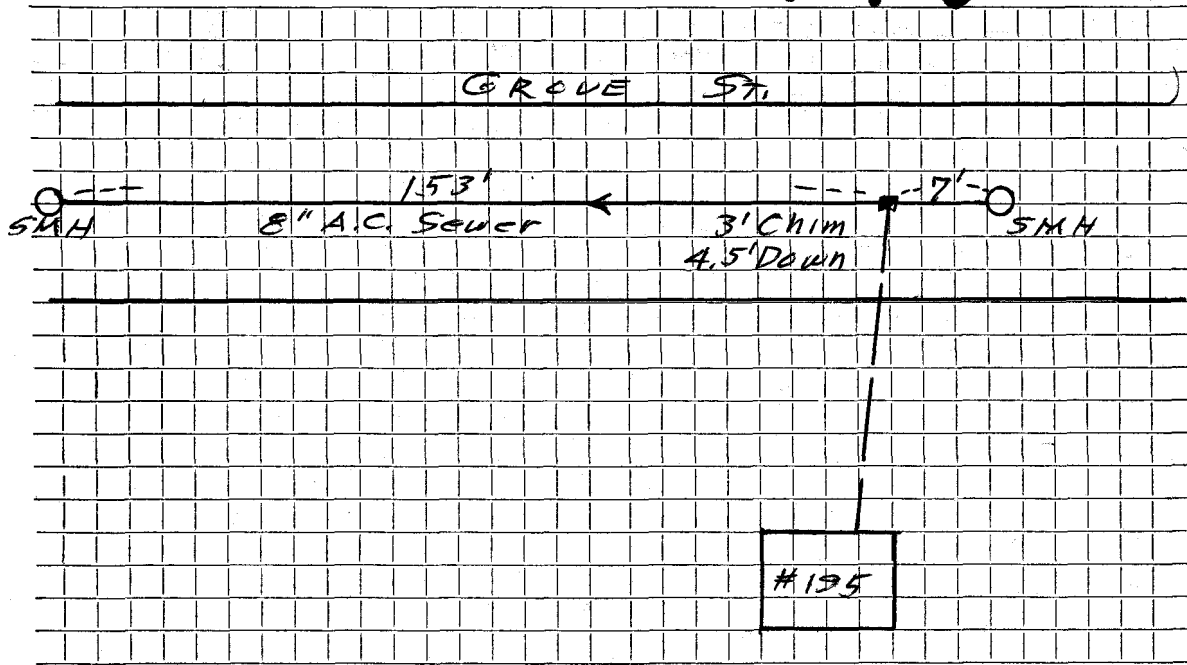

Connection made in Street. Work completed

Remarks:
.....
.....