

Name John DeMars

Service No. 64

Address 198 Grove Street

Location

Kind of Pipe

Size

Size of Main

~~Repair - Renewal~~ - New Service WO #7315


Location Comm 7-16-62

Date	Material	Amount	Total	Date	Amount
6/5/62	Labor	41.36		5-24-62	300.00
6/6/62	"	49.50		5-16-62	74.81
6/8/62	"	6.67	97.53		225.19
	10% O.H.	9.75	107.28		
	65' 6" Transite Pipe @ .78		50.70		
	1 22 1/2° Transite Bend		6.21		
	10 X 3 Patch		10.00		
	6 Hrs. Town Shovel @ 6.50		39.00		
	4 Hrs. Trucking @ 3.00		12.00		
			225.19		

DATE _____

TOWN OF LEXINGTON — BOARD OF PUBLIC WORKS
SEWER DIVISION

Sketch of Service Here **198**

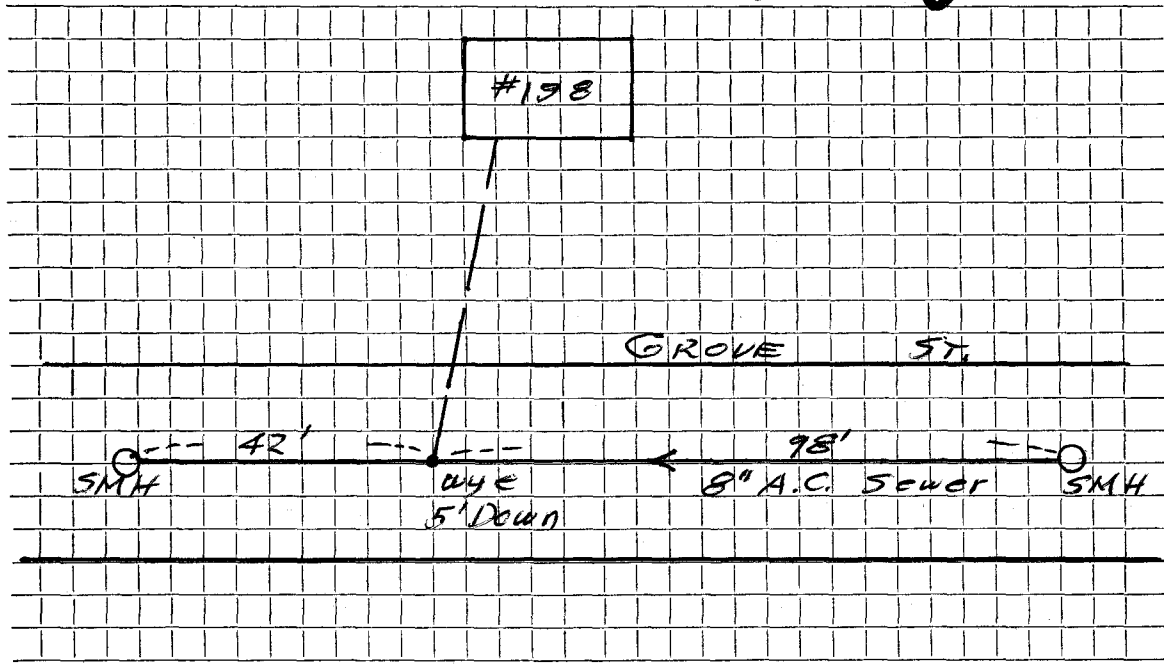

Connection made in Street. Work completed

Remarks:
.....
.....