

Name Barbara Howard

Service No. 155 & 161

Address 199 Grove Street

Location

Kind of Pipe

Size

Size of Main

~~Repair~~ Renewal — New Service

Location *Comm 12-18-61*

Date	Material	Amount	Total	Date	Amount
11/20/61	Labor	73 63		11-2-61	300 00
11/22/61	"	23 22		12-18-61	.37 94
		96 85			262 06
	10% O.H.	9 69	106 54		
	104'6 " Transite Pipe @ .78		81 12		
	1 6" 90° Transite Elbow		5 40		
	7 Hrs. Pippin Shovel @ 5.00		35 00		
	3 Hrs. Trucking @ 3.00		9 00		
	10 X 3 Patch		10 00		
	Loam & Seed		15 00		
			262 06		


DATE _____

TOWN OF LEXINGTON — BOARD OF PUBLIC WORKS

SEWER DIVISION

Sketch of Service Here

199

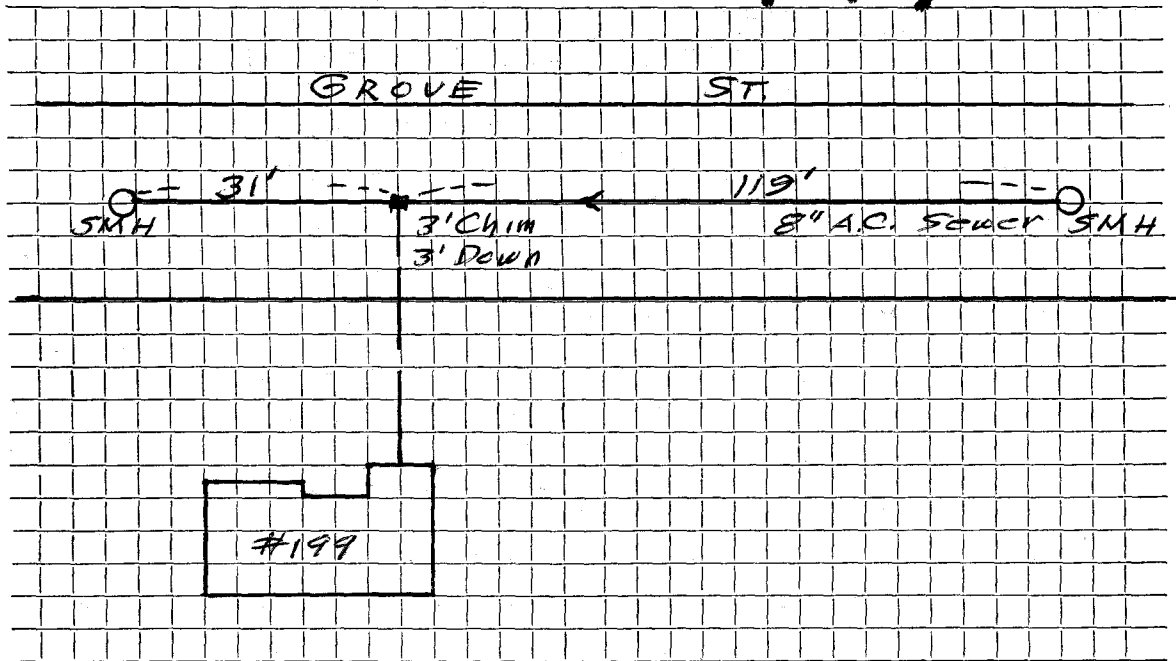

Connection made in Street. Work completed

Remarks:

.....

.....