


DATE _____

TOWN OF LEXINGTON — BOARD OF PUBLIC WORKS

SEWER DIVISION

Sketch of Service Here **2**

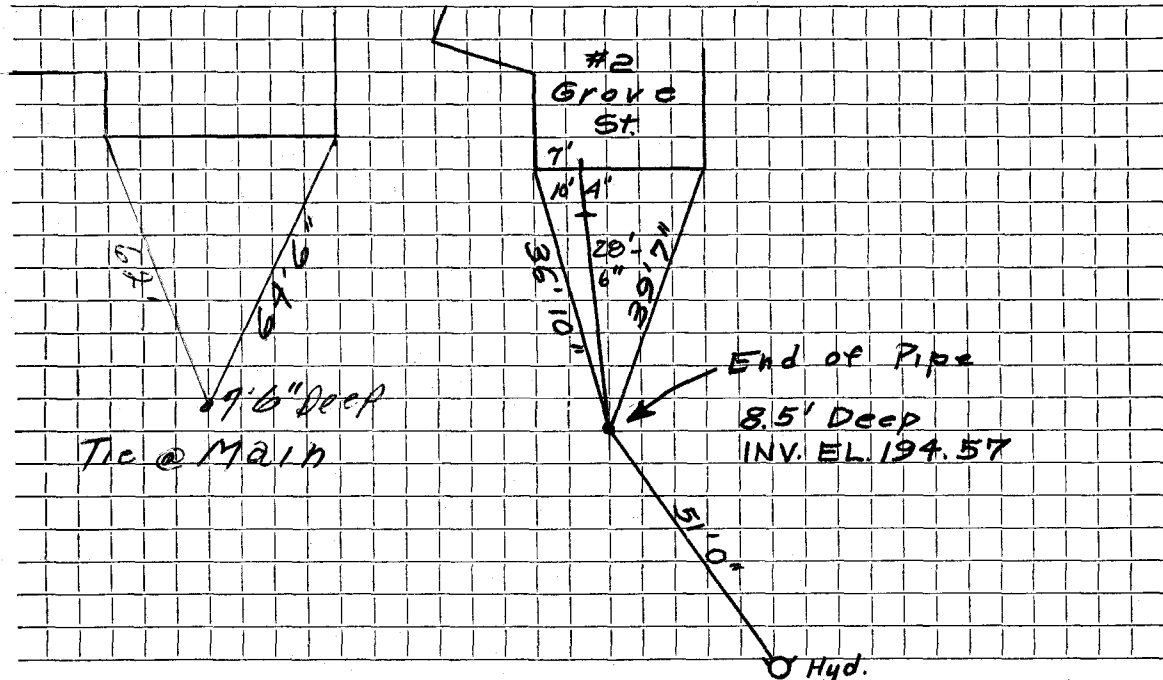

Connection made in .. GROVE .. Street. Work completed .. 11-6-74 ..

Remarks: ..
.....
.....