

Name Johnstone Fitzgerald

Service No. 87

Address #200 GROVE ST.

Location

Kind of Pipe

DeFlice #A365

Size

Size of Main

~~Repair~~ ~~Renewal~~ - New Service W.O. #2935

Location SEP 19 1966


Date	Material	Amount	Total	Date	Amount
7-29-66	Labor	87 86		6-21-66	125 00
	10% O.H.	8 79	96 65	9-19-66	25
27'	6" Transite pipe @ .88		23 76		174 25
1	1 1/4" Bend		4 09	7-29-66	
1	6" Cast iron saddle		5 25	27' 6" Transite	
4	Hrs. Truck @ 3.00		12 00	1 6"-1 1/4" Bend	
5	Hrs. Shovel @ 6.50		32 50	1 6" X 8" Saddle	
			174 25		
8/12/66	45' 6" Transite pipe				

DATE _____

TOWN OF LEXINGTON — BOARD OF PUBLIC WORKS
SEWER DIVISION

Sketch of Service Here

200

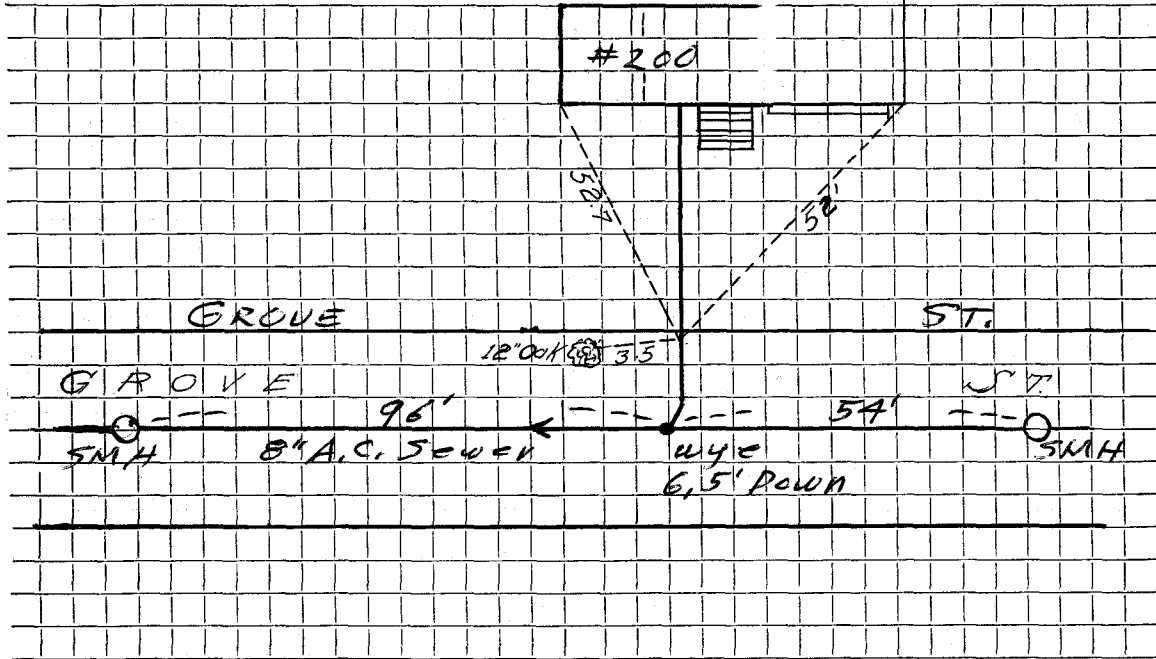

Connection made in Street. Work completed

Remarks:
.....
.....