

Name John C. Milne

Service No.

169

Address 203 Grove St., Lexington, Mass.

Location

Kind of Pipe

Size

Size of Main

~~Repair - Renewal~~ New Service

Location Comm 12-31-61

Date	Material	Amount	Total	Date	Amount
11/20/61	Labor	109.20		11-13-61	300.00
11/24/61	"	26.70	135.90	12-31-61	1.21
	10% O.H.	13.59	149.49		298.79
	91' 6" Transite Pipe @ .78		70.98		
	2 22 $\frac{1}{2}$ " Transite Bends @ 6.21		12.42		
	1 6" 90° Transite Elbow		5.40		
	3 Hrs. Town Shovel @ 6.50		19.50		
	3 Hrs. Trucking @ 3.00		9.00		
	17 X 3 Patch		17.00		
	Spring - Loam & Seed		15.00		
			298.79		


DATE _____

TOWN OF LEXINGTON — BOARD OF PUBLIC WORKS

SEWER DIVISION

Sketch of Service Here

203

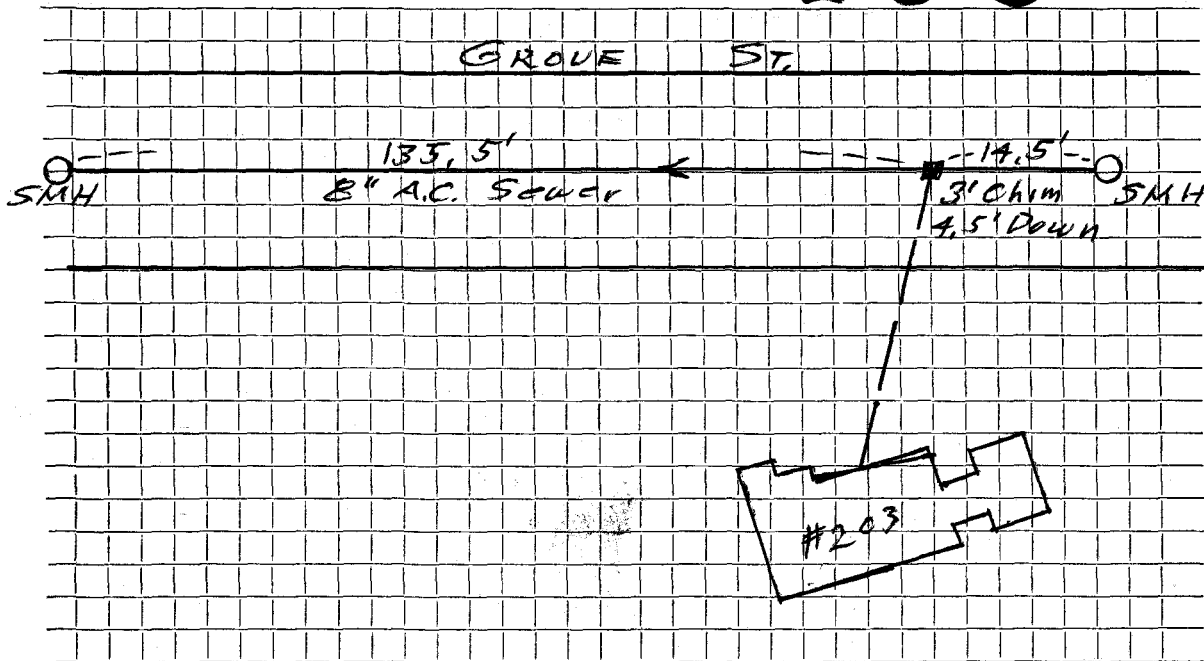

Connection made in Street. Work completed

Remarks:
.....
.....