


DATE _____

TOWN OF LEXINGTON — BOARD OF PUBLIC WORKS
SEWER DIVISION

Sketch of Service Here

205

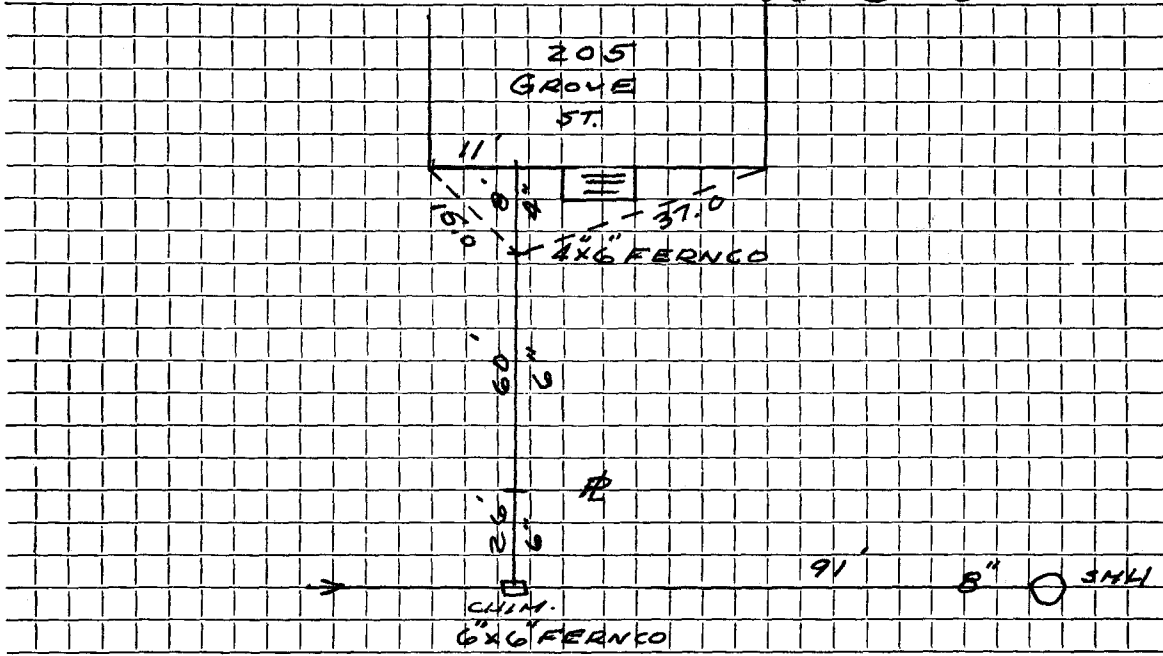

Connection made in GROVE Street. Work completed

Remarks: J. McLAUGHLIN CONTR.

CHIM. EXIST.