

Name Johnstone Fitzgerald

Service No. 10

Address 208 Grove Street

Location

Kind of Pipe

Size

Size of Main

~~Repair~~ Renewal — New Service

W.O. #8557

Location

DEC 28 1964

Date	Material	Amount	Total	Date	Amount
7-20-64	Labor	75 57		2-11-64	320 00
	10% O.H.	7 56	83 13	12-28-64	118 94
68'	6" Transite Pipe @.82		55 76		201 06
1	Bag Cement		1 50		
1	6X8 Saddle		5 25		
1	90° Elbow		4 09		
5	X 5 Sidewalk Patch		8 33		
12	X 5 Street Patch		20 00		
2	Hrs. Town Shovel @6.50		13 00		
2	Hrs. Town Truck @3.00		6 00		
1	Hr. Loader		4 00		
			201 46		


DATE _____

TOWN OF LEXINGTON — BOARD OF PUBLIC WORKS

SEWER DIVISION

Sketch of Service Here

208

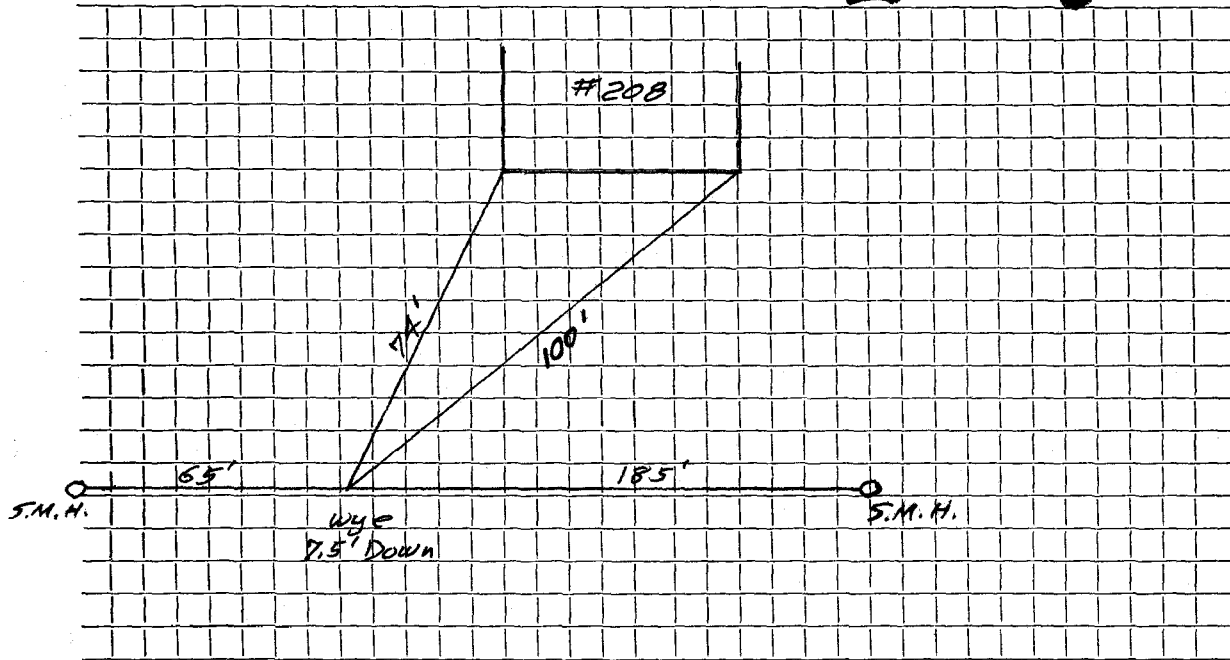

Connection made in Street. Work completed

Remarks:

.....

.....