

Name

Service No.

Address # 209 GROVE ST.

Location

Kind of Pipe

Size

Size of Main

Repair—Renewal—New Service

Location

Date	Material	Amount	Total	Date	Amount


DATE _____

TOWN OF LEXINGTON — BOARD OF PUBLIC WORKS

SEWER DIVISION

Sketch of Service Here

209

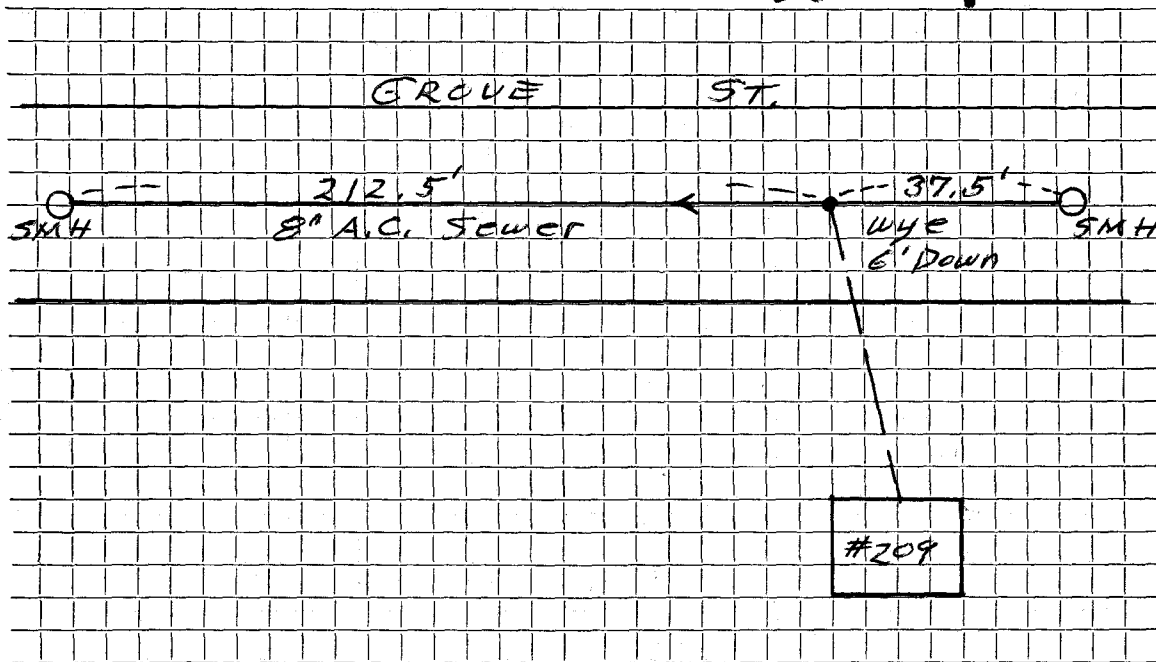

Connection made in Street. Work completed

Remarks:
.....
.....