

Name

Service No.

Address 223 Grove St

Location

Kind of Pipe AC

Size C"

Size of Main 8"

Repair—Renewal—New Service

Location

| Date | Material | Amount | Total | Date | Amount |
|---------|-------------|----------|-----------|-------------|--------|
| 7-10-75 | 18'-6" AG @ | \$ 10.00 | \$ 180.00 | 7-10-75 | |
| | | | | 18' 6" A.C. | |
| | | | | | |
| | | | | | |

DATE _____

TOWN OF LEXINGTON — BOARD OF PUBLIC WORKS

SEWER DIVISION

Sketch of Service Here

223

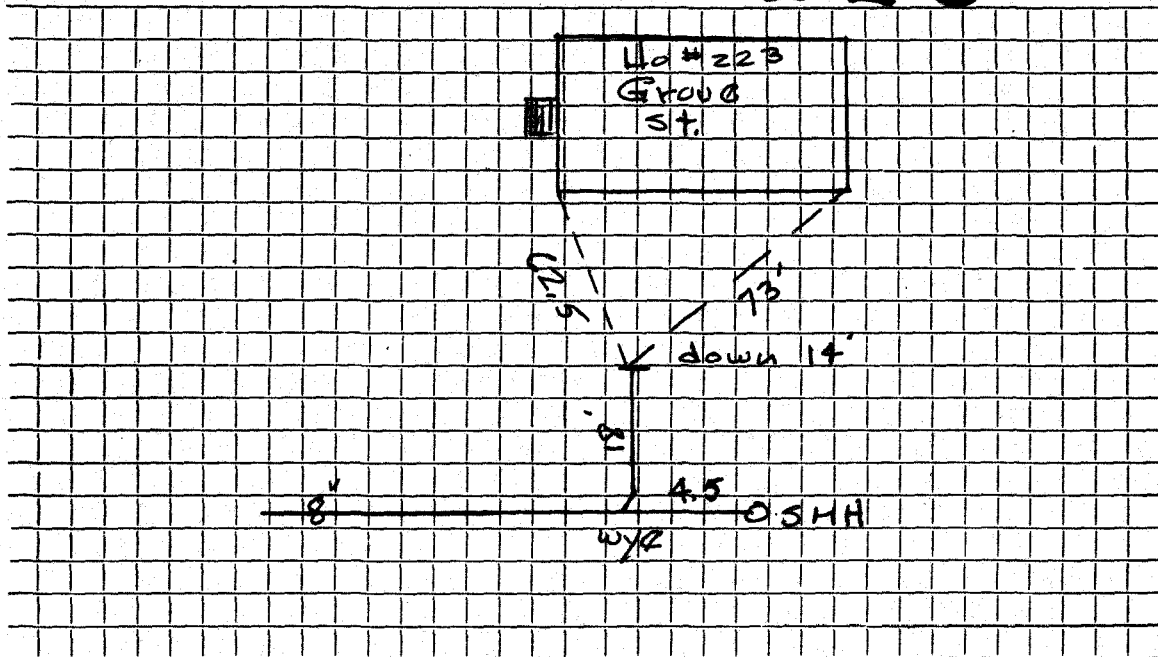

Connection made in Group St. Street. Work completed

Remarks:
.....
.....