

Name

Service No.

Address 227 Grove St.

Location

Kind of Pipe AC

Size 6"

Size of Main 8"

Repair—Removal—New Service

Location

Date	Material	Amount	Total	Date	Amount
7-8-75	13' 6" AC @	10.00 =	130.00	7-8-75	
				13' 6" A.C.	

DATE _____


TOWN OF LEXINGTON — BOARD OF PUBLIC WORKS

SEWER DIVISION

Sketch of Service Here

227

Ho. # 227
Grova St

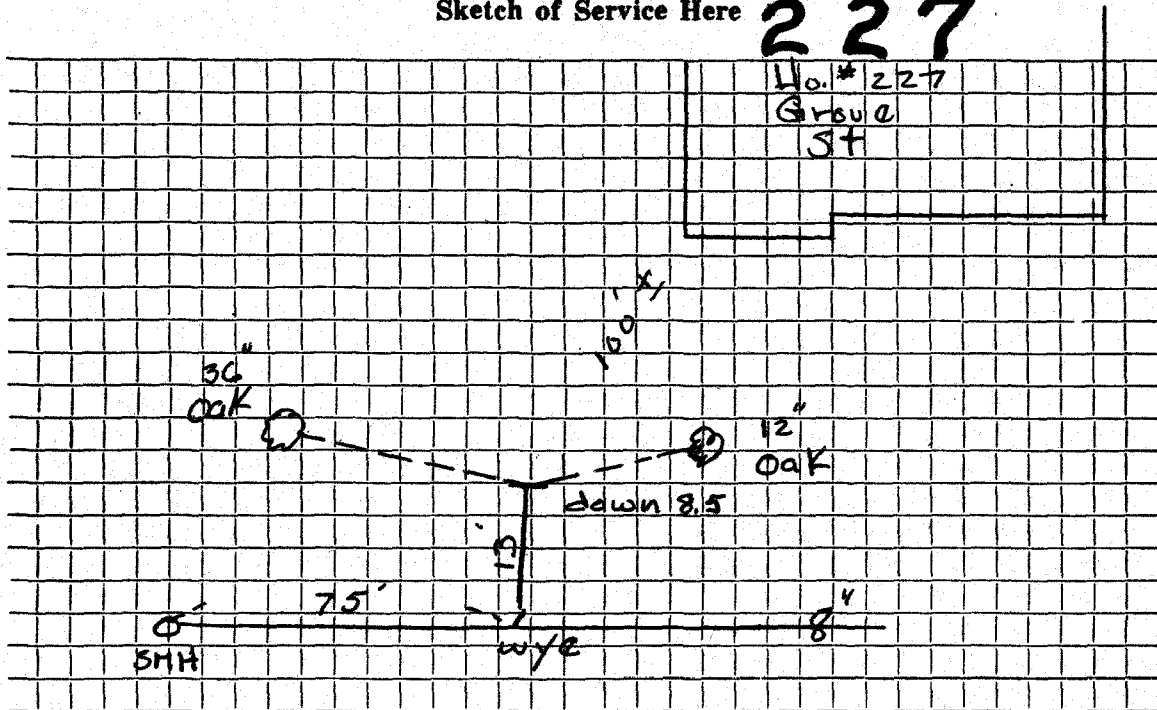

Connection made in Grova St. Street. Work completed

Remarks: