




DATE 11/3/22

TOWN OF LEXINGTON — BOARD OF PUBLIC WORKS  
SEWER DIVISION

Sketch of Service Here

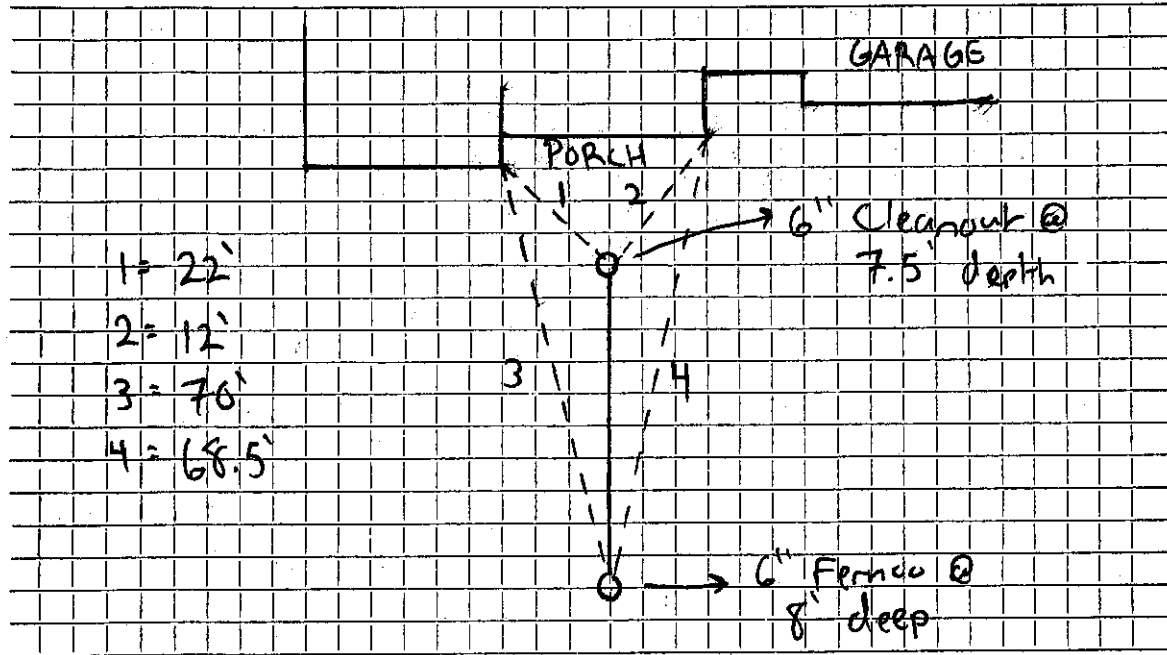

Connection made in ..... Street. Work completed .....

Remarks: INSTALLED BY SPEEDWAGON PARTNERS .....