

Name Mr. Sheldon Weisman

Service No. 116 (75)

Address 240 Grove St.

Location

Kind of Pipe AC

Size 6"

Size of Main 8"

Repair—Renewal—New Service Valeri Const. #2761

Location AUG 16 1976


Date	Material	Amount	Total	Date	Amount
<del>7-7-75</del>	<del>31' 6" AC</del>	<del>10.00</del>	<del>310.00</del>	10/22/75	Deposit 310.00
10/23/75	42' 6" Transite Pipe				
	20' 4" Cast Iron Pipe			7-7-75	
				31' 6" A.C.	

1.9.4.18501

DATE \_\_\_\_\_

TOWN OF LEXINGTON — BOARD OF PUBLIC WORKS  
SEWER DIVISION

Sketch of Service Here **240**

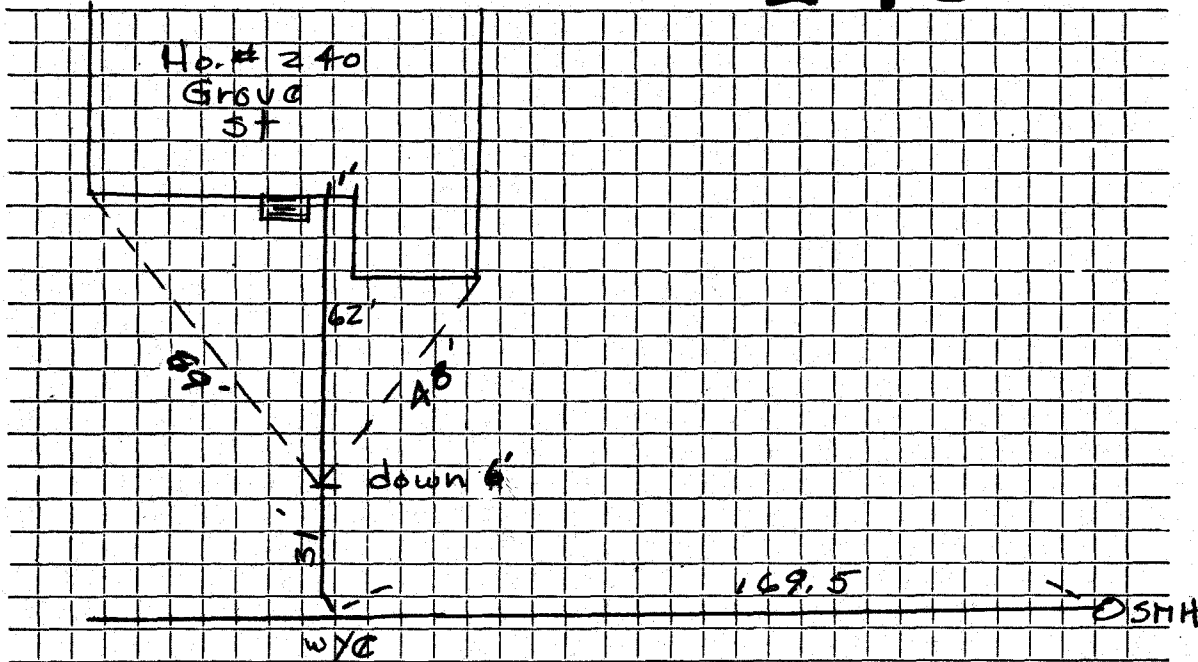

Connection made in Grove St. Street. Work completed 10-23-75

Remarks: .....

.....

.....