

Name Thomas Wright

Service No. 122 (75)

Address 241 GROVE ST

Location

Kind of Pipe A.C.

Size 6"

Size of Main 8"

Repair—Renewal—New Service

Anthony Griecci #2767

Location

AUG 16 1976

Date	Material	Amount	Total	Date	Amount
2-8-75	11' 6" A.C.	10.00	=	10/30/75	Deposit
11/4/75	80' 6" Transite Pipe				
	12' 4" Cast Iron Pipe			7-8-75	
					11' 6" A.C.


DATE _____

TOWN OF LEXINGTON — BOARD OF PUBLIC WORKS

SEWER DIVISION

Sketch of Service Here

241

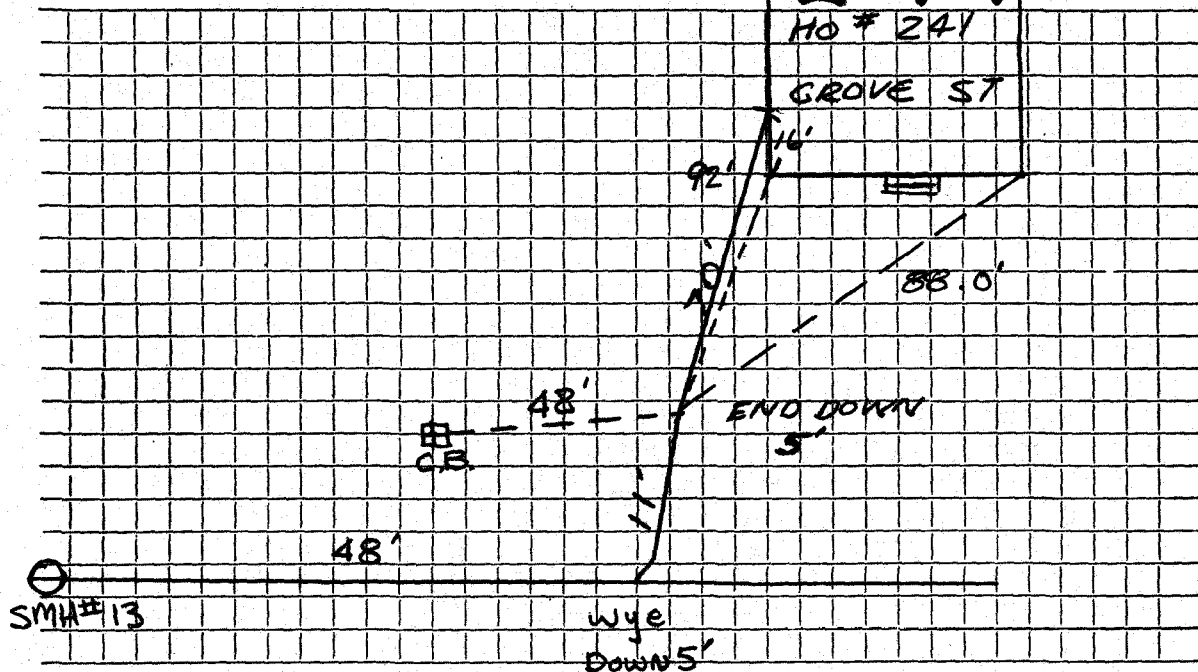

Connection made in GROVE Street. Work completed 11-4-75

Remarks:

.....

.....