




DATE \_\_\_\_\_

TOWN OF LEXINGTON — BOARD OF PUBLIC WORKS

SEWER DIVISION

Sketch of Service Here

242

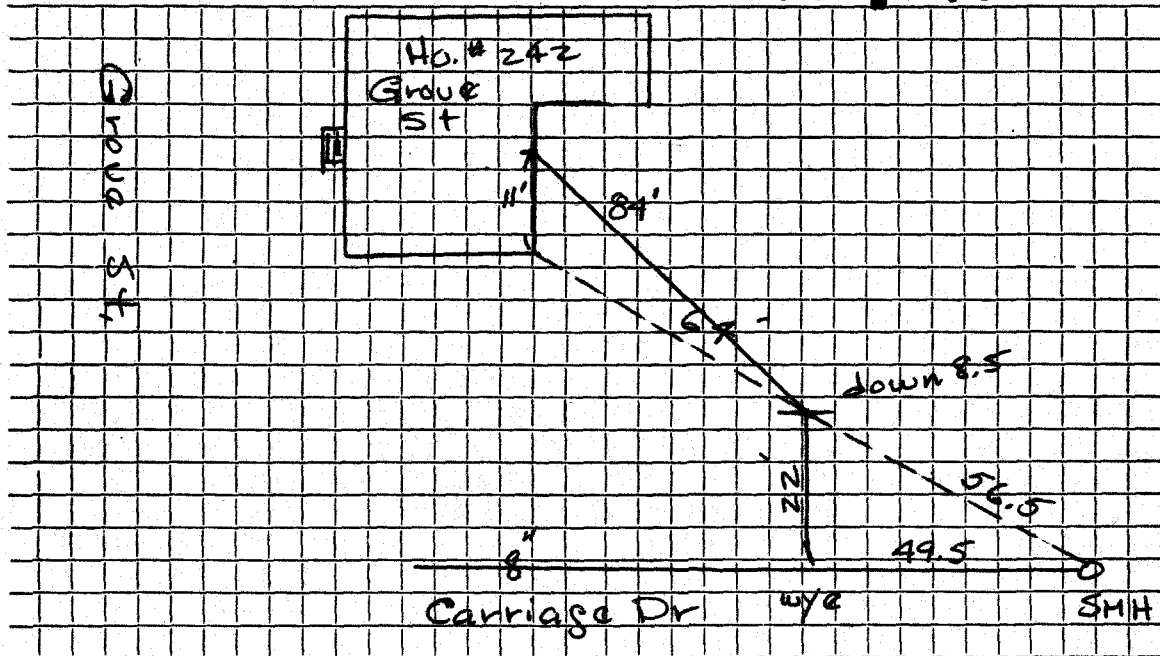

Connection made in Carriage Dr Street. Work completed 12-3-75

Remarks: .....

.....

.....