


DATE _____

TOWN OF LEXINGTON — BOARD OF PUBLIC WORKS
SEWER DIVISION

Sketch of Service Here **248**

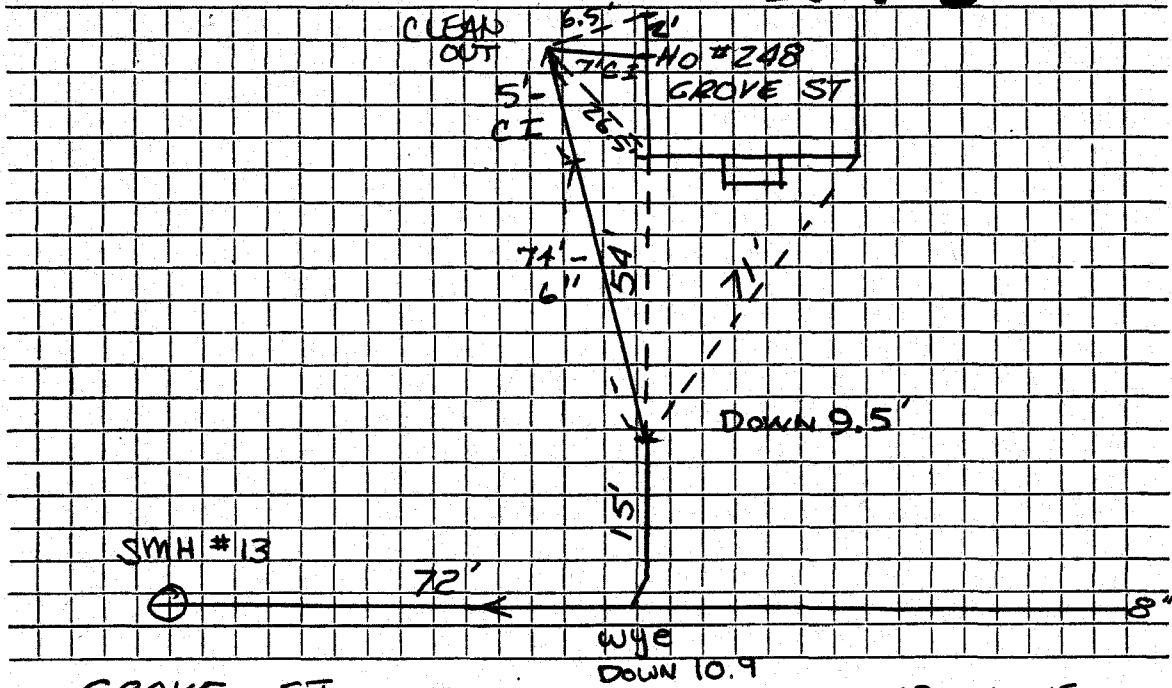

Connection made in GROVE ST Street. Work completed 12-3-79

Remarks:

.....

.....