


DATE _____

TOWN OF LEXINGTON — BOARD OF PUBLIC WORKS
SEWER DIVISION

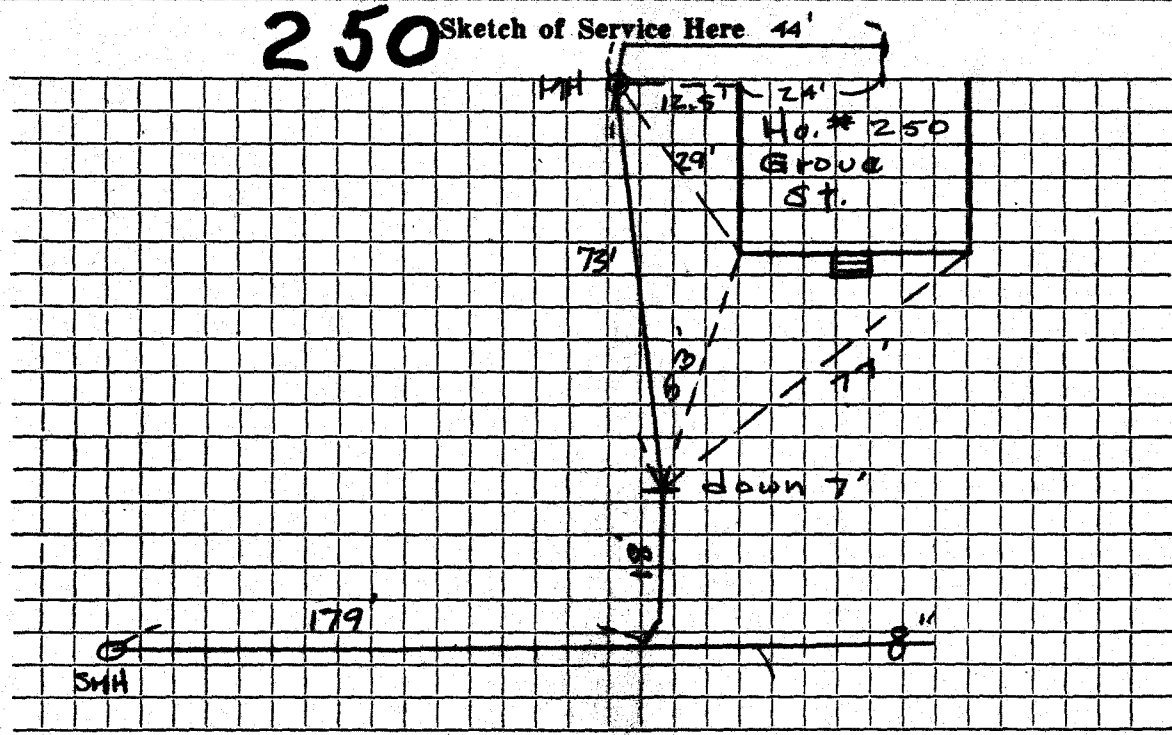

Connection made in Grove St. Street. / Work completed 12-18-75

Remarks:

.....

.....