

Name James V. Cosgrove

Service No. 116

Address 30 Grove Street

Location

Kind of Pipe

Size

Size of Main

~~Repair - Removal~~ - New Service

W.C.# 8933

Location

Comm 9-21-64

Date	Material	Amount	Total	Date	Amount
8-21-64	Labor 64.15			7-15-64	325.00
8-24-64	" 35.79	99 94		7-31-64	81.98
	10% O.H.	9 99	109 93		243.02
75'	6" Transite pipe @.82		61 50		
1	90° Transite elbow		4 09		
1	Bag Cement		1 50		
7	Yds. Loam @3.00		21 00		
10'	x 3 Patch		10 00		
4	Hrs. Town Shovel @6.50		26 00		
3	Hrs. Trucking @3.00		9 00		
			243 02		


DATE \_\_\_\_\_

TOWN OF LEXINGTON — BOARD OF PUBLIC WORKS

SEWER DIVISION

Sketch of Service Here

30

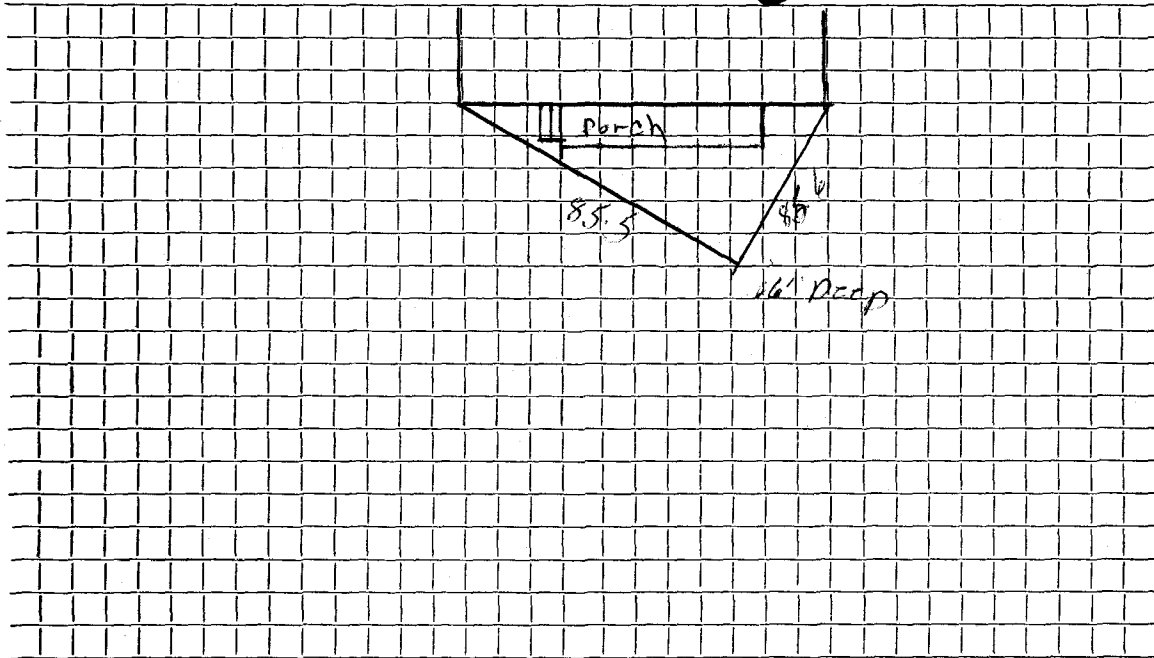

Connection made in ..... Street. Work completed .....

Remarks: .....  
.....  
.....