


DATE JULY 20, 2001

TOWN OF LEXINGTON — BOARD OF PUBLIC WORKS

SEWER DIVISION

Sketch of Service Here

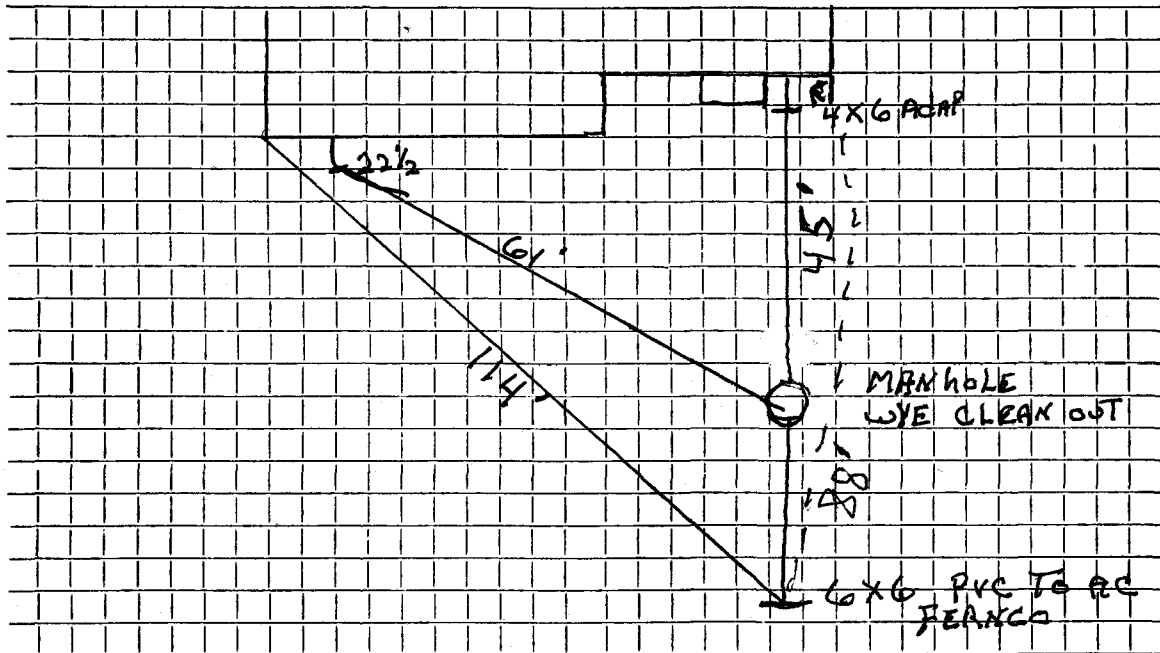

Connection made in ... GROVE ST Street. Work completed ... JULY 21, 2001

Remarks:
.....
.....