

Name WINTERPORT RT

Service No.

Address #41 GROVE STREET

Location

Kind of Pipe

Size

Size of Main

Repair—Renewal

New Service

PERMIT NO. 0973-MCIVER BROTHERS

Location

Date

Material

Amount

Total

Date

Amount

JUNE 13, 1997

93.5' - 6"  $\phi$  PVC

8.5' - 4"  $\phi$  PVC

1-WYE CLEANOUT


JUNE 13, 1997

20' - 6"  $\phi$  PVC

DATE JUNE 13, 1997

TOWN OF LEXINGTON — BOARD OF PUBLIC WORKS  
SEWER DIVISION

Sketch of Service Here

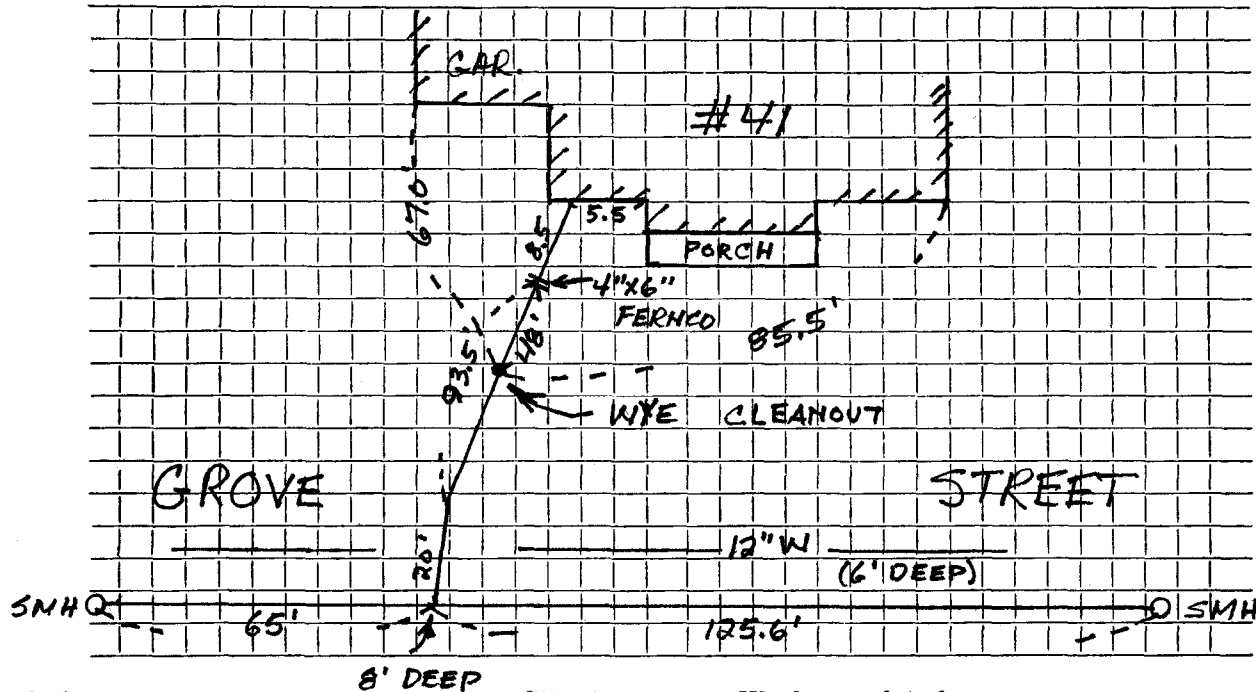

Connection made in ..... Street. Work completed .....

Remarks: .....