


DATE 8/2/2017

TOWN OF LEXINGTON — BOARD OF PUBLIC WORKS
SEWER DIVISION

Sketch of Service Here

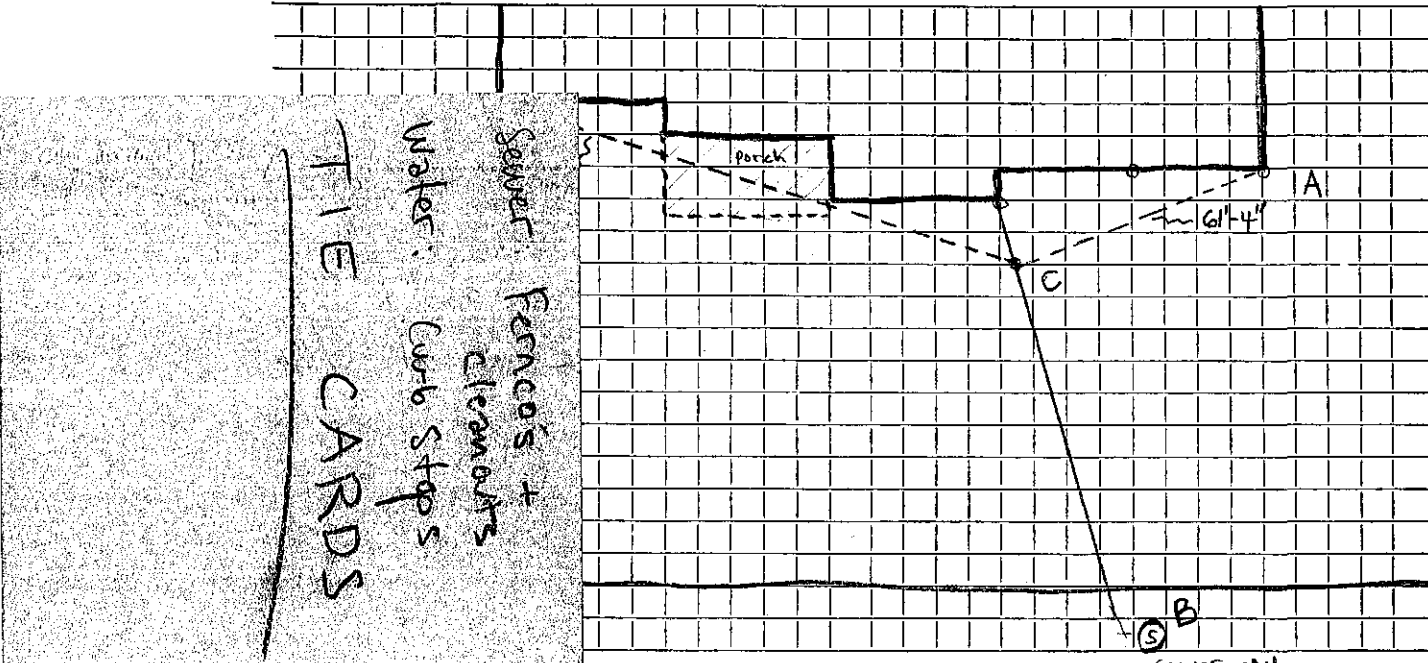

Connection made in 44 Grove Street Street. Work completed

Remarks: Sewer shut off valve 7 foot depth