


DATE _____

TOWN OF LEXINGTON — BOARD OF PUBLIC WORKS SEWER DIVISION

Sketch of Service Here

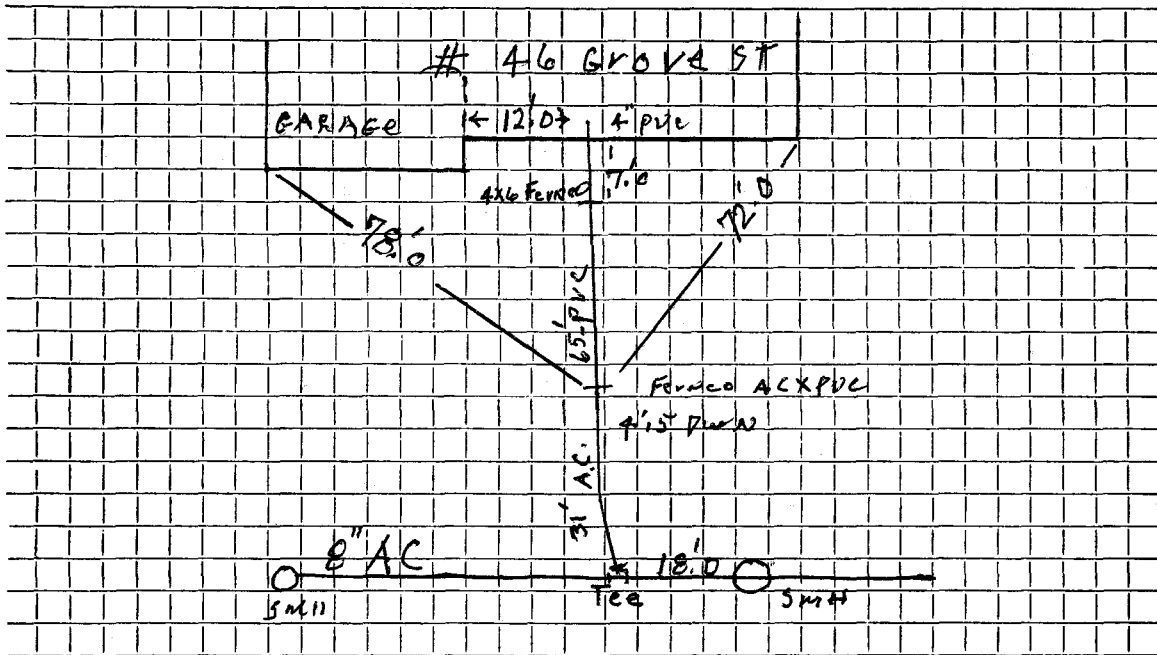

Connection made in Street.

Work completed 12/11/04 J. McLaughlin

Remarks:

.....

.....