


DATE _____

TOWN OF LEXINGTON — BOARD OF PUBLIC WORKS
SEWER DIVISION

Sketch of Service Here

48

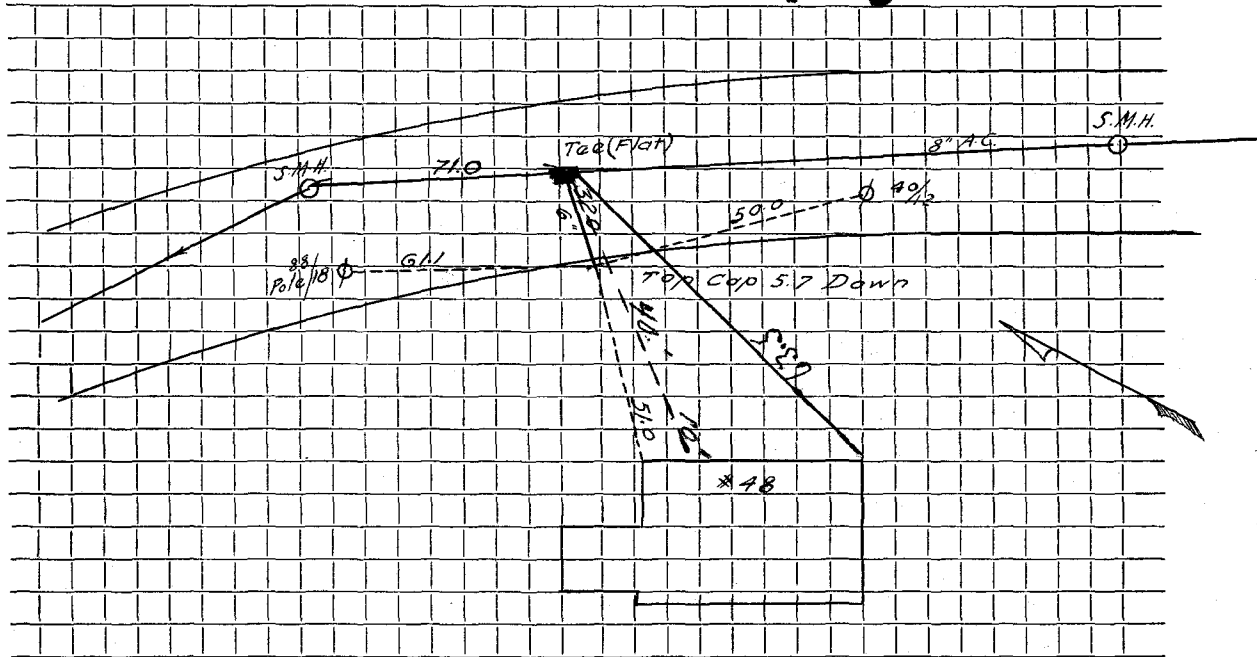

Connection made in *S.S. Deep* Street. Work completed

Remarks:
.....
.....