

Name **Edwin A. Bennett**

Service No. 93

Address **52 Grove Street**

Location

Kind of Pipe

Size

Size of Main

Repair—Renewal—New Service **Suburbanite Cesspool Service 726**

Location

SEP 5 1967

Date	Material	Amount	Total	Date		Amount
<del>Jan 1-67</del>	<del>34' 6" Transite pipe @7.00</del>		238.00	8-3-67	<i>Deposit</i>	238.00
3-18-67	55' Transite pipe			6- -67	34' 6" Transite	
	10' Iron cast				1 6" X 8" Wye	


H.B.M.18501

DATE \_\_\_\_\_

TOWN OF LEXINGTON — BOARD OF PUBLIC WORKS  
SEWER DIVISION

Sketch of Service Here

52

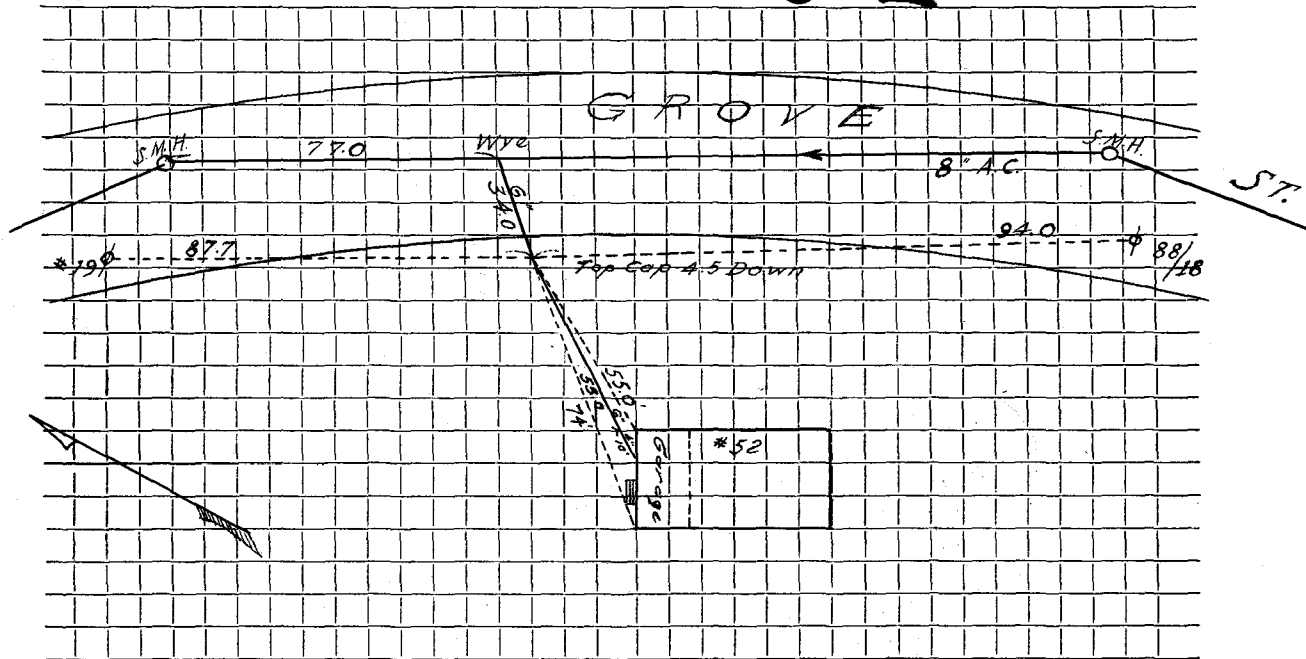

Connection made in ..... Street. Work completed .....         

Remarks: .....  
.....  
.....