

Name Roy B. Maynard

Service No. 83

Address 6 Grove Street

W.O. #8744

Location

Kind of Pipe

Size

Size of Main

~~Repair - Renewal~~ - New Service

Location

DEC 28 1904


Date	Material	Amount	Total	Date	Amount
5-24-64	Labor	94 91		5-8-64	Deposit 225 00
	10% O.H.	9 49	104 40	12-28-64	Retard 32 03
39'	6" Transite Pipe @.82		31 98		192 97
1	Bag Cement		1 50		
1	90° Transite Elbow		4 09		
10	X 3 Patch		10 00		
3	Yds. Loam @3.00		9 00		
4	Hrs. Town Shovel @6.50		26 00		
2	Hrs. Trucking @3.00		6 00		
			192 97		

DATE _____

TOWN OF LEXINGTON — BOARD OF PUBLIC WORKS

SEWER DIVISION

Sketch of Service Here

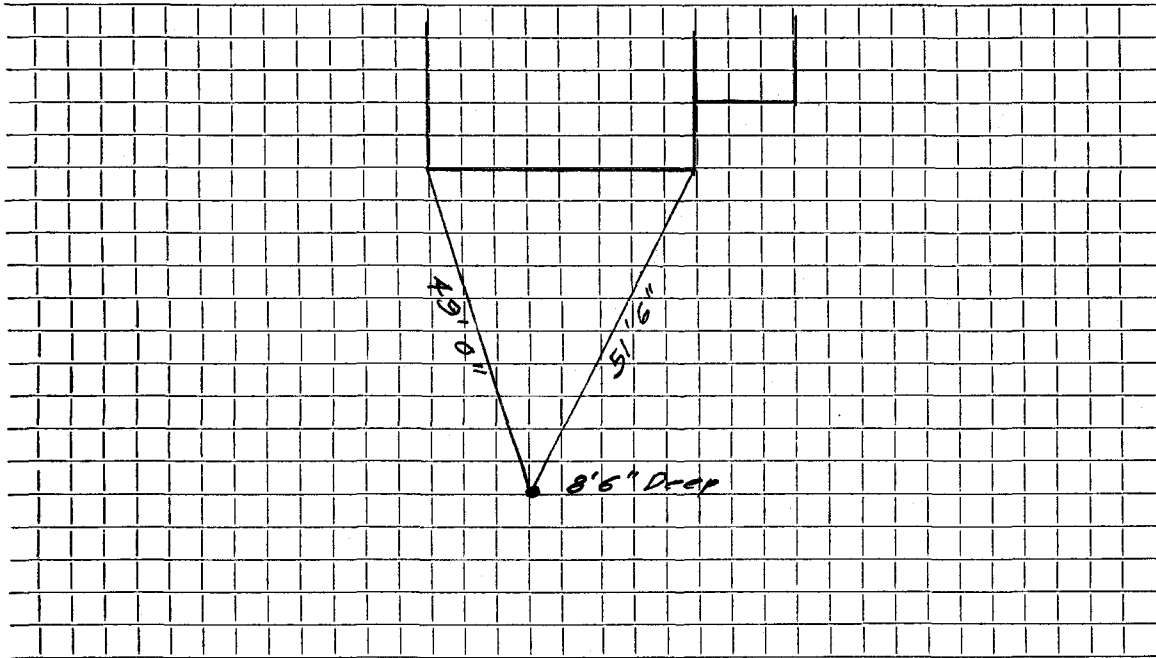

Connection made in Street. Work completed

Remarks:

.....

.....