

Name Carlo Eracleo

Service No. 12

Address 91 Grove Street

Location

Kind of Pipe

Size

Size of Main

Repair—Renewal—New Service

Kelley (Plumbing Ins.)

Location APR 21 1971


Date	Material	Amount	Total	Date	Amount
1971	24' 6" Transite pipe @7.00		168.00	3-31-71	340.00
6/22/71	50' 4" Cast Iron			7-2-71	172.00
					168.00
				'71	
				24' 6" Transite	

DATE _____

TOWN OF LEXINGTON — BOARD OF PUBLIC WORKS
SEWER DIVISION

Sketch of Service Here

91

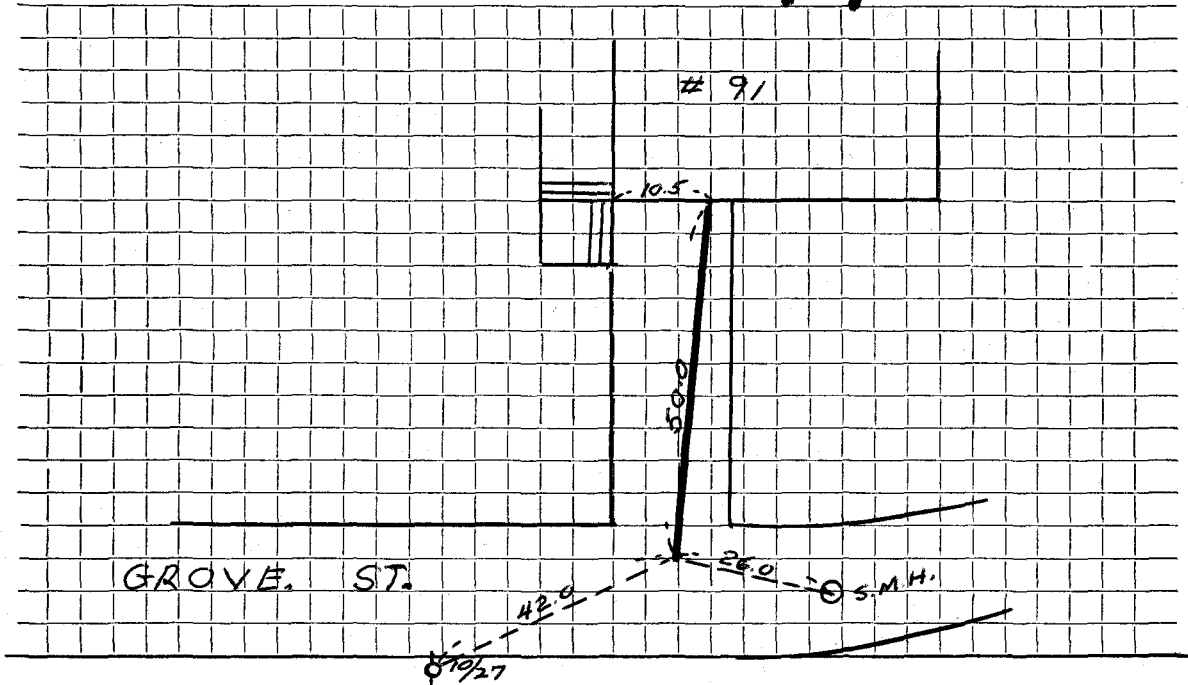

Connection made in Street. Work completed

Remarks:
.....
.....