

Name

Service No.

Address 93 Grove Street

Location

Kind of Pipe

Size

Size of Main

Repair—Renewal—New Service

Location


| Date | Material | Amount | Total | Date | Amount |
|---------|---|--------|-------|---------|---|
| | Most likely connected in June 1971 | | | | |
| 8/31/79 | Frank Leahy and Bill DiAloia checked sewer August 31, 1979 definitely connected | | | 3-2-06 | Roots in back edge of sidewalk will need to be dug Respond if called |
| | | | | 3-22-06 | REPAIR MADE IN DRIVEWAY |

DATE _____

TOWN OF LEXINGTON — BOARD OF PUBLIC WORKS

SEWER DIVISION

Sketch of Service Here

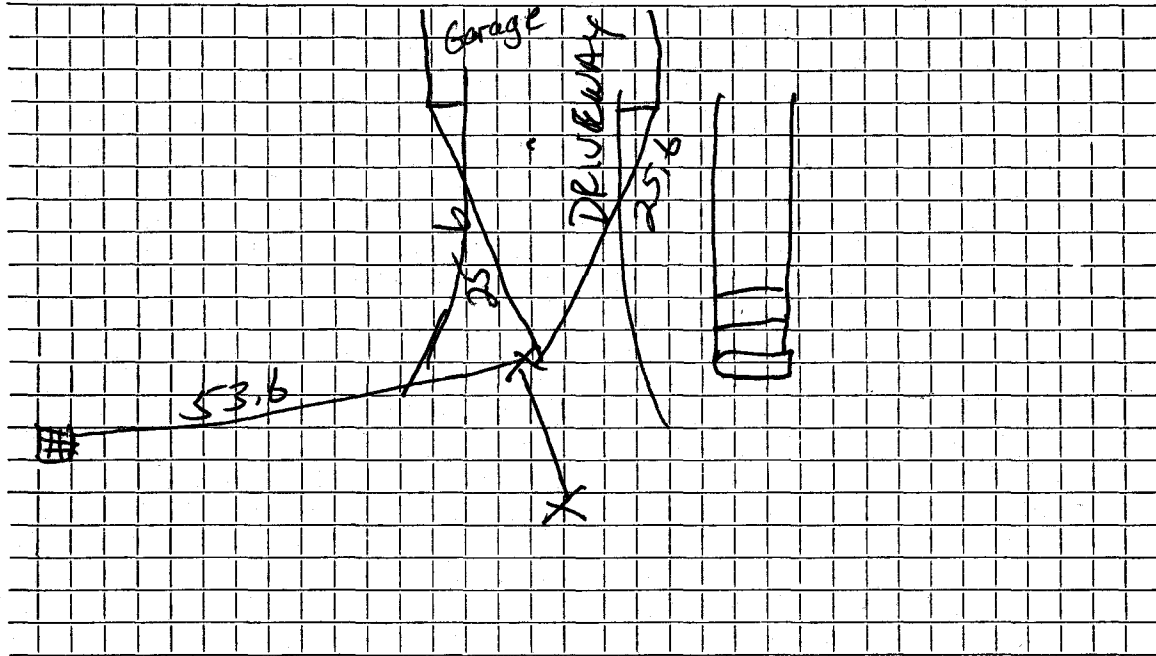

Connection made in Street. Work completed
Remarks: *repair made* *6' - 6" PVC 2-6x6 PVC to AC*
..... *3' deep* *FRANCOS*