

Name Arthur F. Antil

Service No. 65

Address 95 Grove Street

Location Lot N

Kind of Pipe

Size

Size of Main

Repair—Renewal—New Service Sibley #1408

Location SEP 2 1969

Date	Material	Amount	Total	Date	Amount	
1967	6' 6" Transite pipe @	7.00	42 00	7-8-69	Deposit	42 00
8-8-69	7' 4" Transite pipe					
	31' 6" Cast Iron pipe					
8-8-69	7' 4" C.I. Pipe			1969		
	31' 6" Transite			6' 6" Transite		
				1 6" X 8" Tee		


DATE _____

TOWN OF LEXINGTON — BOARD OF PUBLIC WORKS

SEWER DIVISION

Sketch of Service Here

95

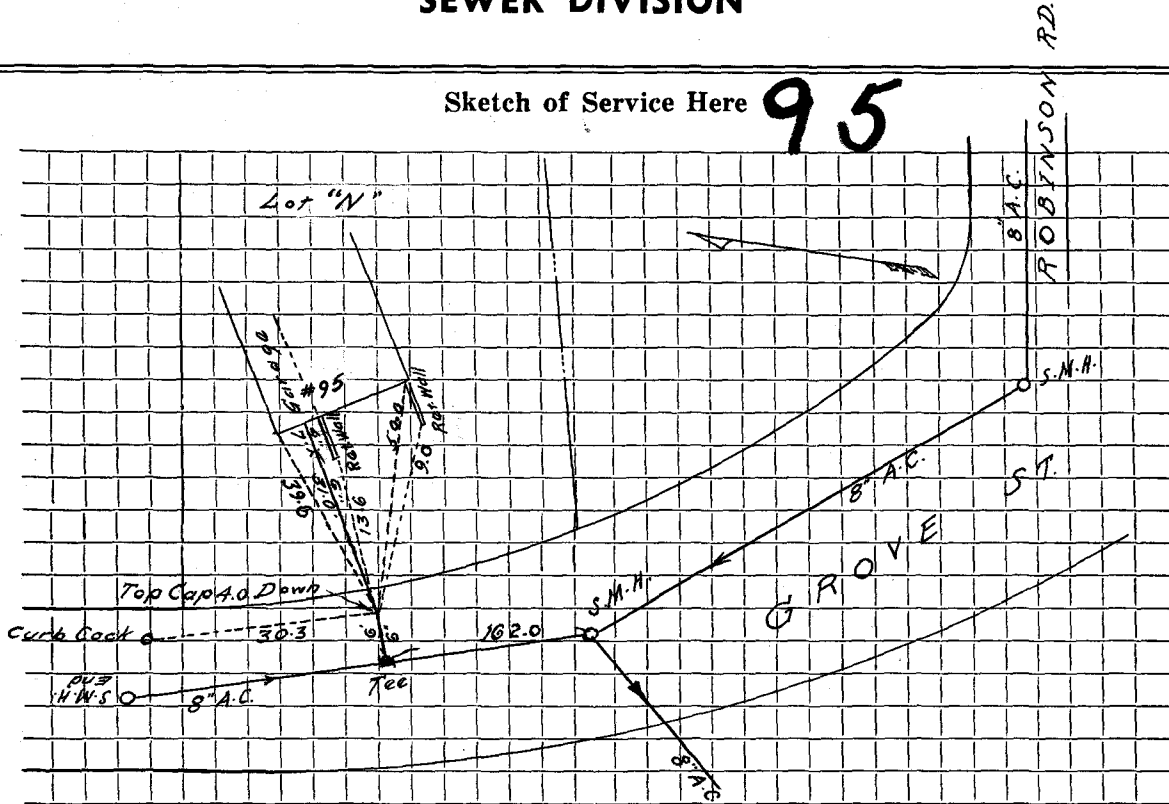

Connection made in Street. Work completed

Remarks:

.....

.....