

Name

Service No.

Address

Lot # 195

Location

Kind of Pipe

Size

Size of Main

~~Repair Work~~ — New Service W O. # 7848

Location

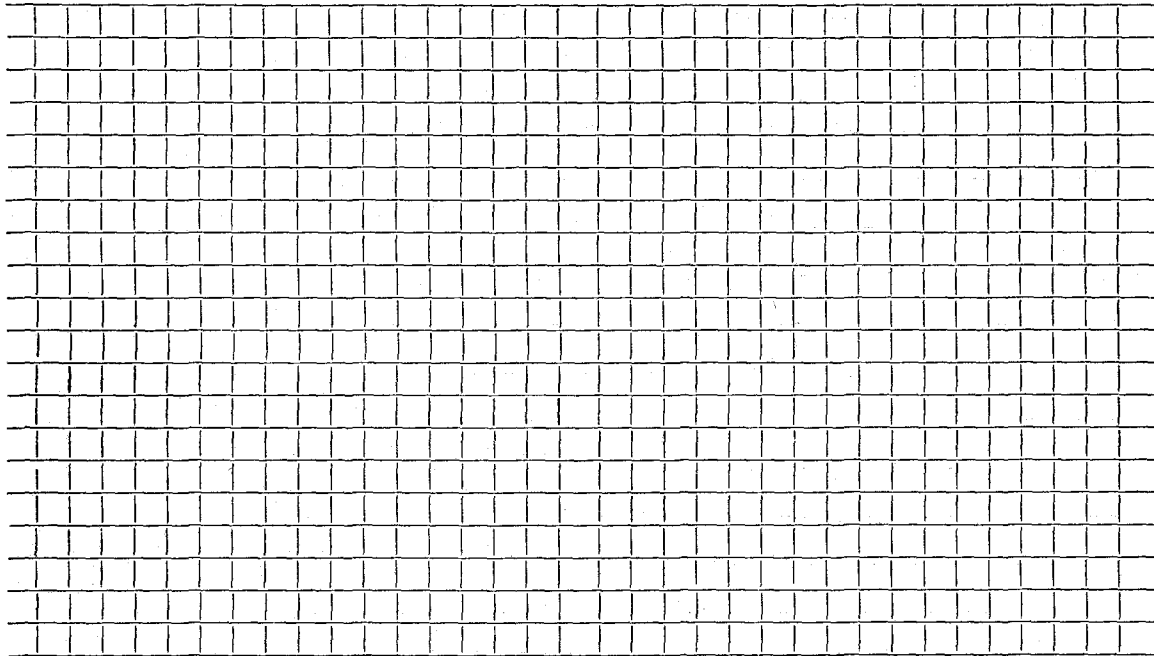
Date		Material	Amount	Total	Date	Amount
7/29/70		Labor	127 04			
8/6/70		"	11 56			
	10%	O.H.	13 86	152 46		
	30'	6" TRansite pipe .90		27 00		
	1	6"x6" Nipple		91		
	1	90o Elbow		5 09		
	1	Ton cold patch		6 00		
	4	Hrs. shovel 6.50		26 00		
	2	Hrs. Truck 3.00		6 00		
	1	Hr. Compressor		4 00		
		Patching		45 00		
				272 46		

DATE _____

TOWN OF LEXINGTON — BOARD OF PUBLIC WORKS

SEWER DIVISION

Sketch of Service Here

A large grid of graph paper, consisting of approximately 20 columns and 25 rows of small squares, intended for sketching sewer service details.

Connection made in Street. Work completed

Remarks:
.....
.....