

Name

Service No.

Address *Grove St*

Lot # 89-61 (Opp. Ho. # 223)

Location

Kind of Pipe *AC*

Size *6"*

Size of Main *8"*

Repair—Renewal—New Service

Location


Date	Material	Amount	Total	Date	Amount
8-4-75	32'-6" AC @	10.00 =	320.00	8-11-75	
				<i>32'-6" A.C.</i>	

DATE _____

TOWN OF LEXINGTON — BOARD OF PUBLIC WORKS

SEWER DIVISION

Sketch of Service Here

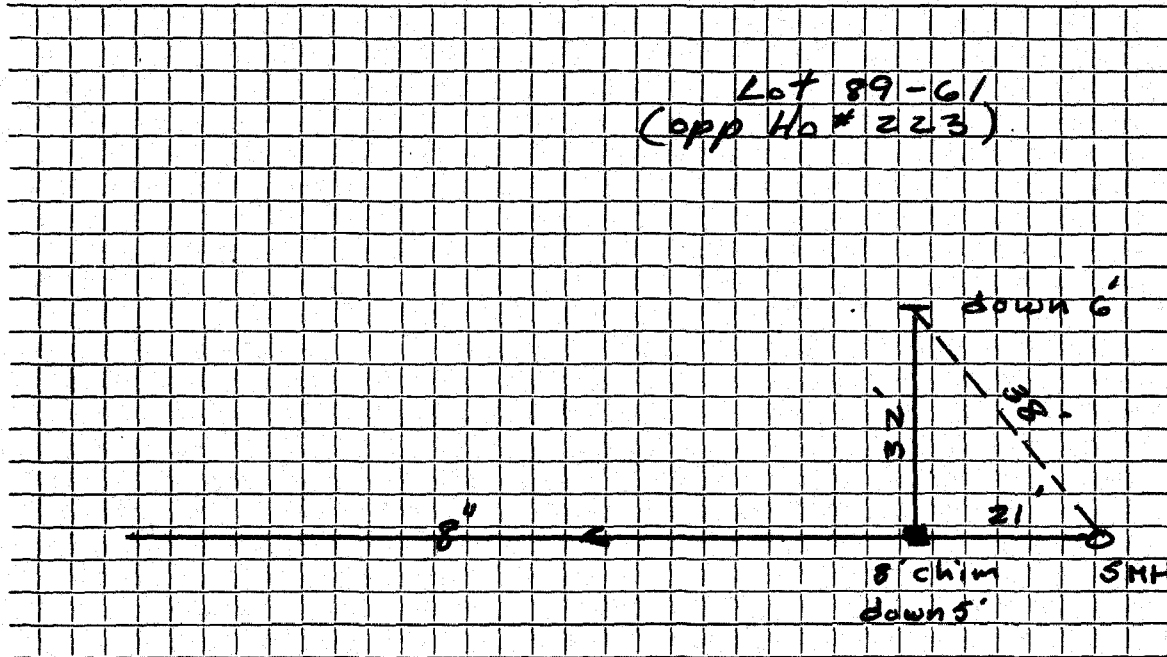

Connection made in Grove St. Street. Work completed

Remarks:
.....
.....