

Name

Service No.

Address

Proposed lot across from #162 Grove St, Location

Kind of Pipe

Size

Size of Main

Repair—Renewal—New Service

Location


Date		Material	Amount		Total		Date		Amount	

DATE _____

TOWN OF LEXINGTON — BOARD OF PUBLIC WORKS

SEWER DIVISION

Sketch of Service Here

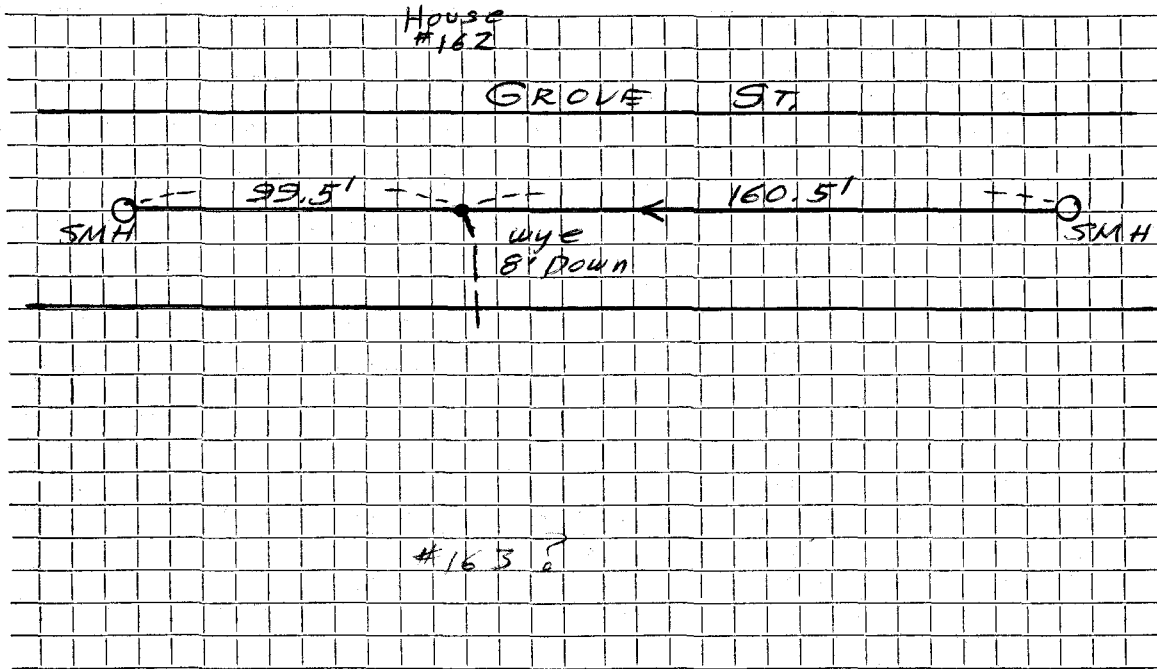

Connection made in Street. Work completed

Remarks:
.....
.....