




DATE \_\_\_\_\_

# TOWN OF LEXINGTON — BOARD OF PUBLIC WORKS

## SEWER DIVISION

Sketch of Service Here

# 10

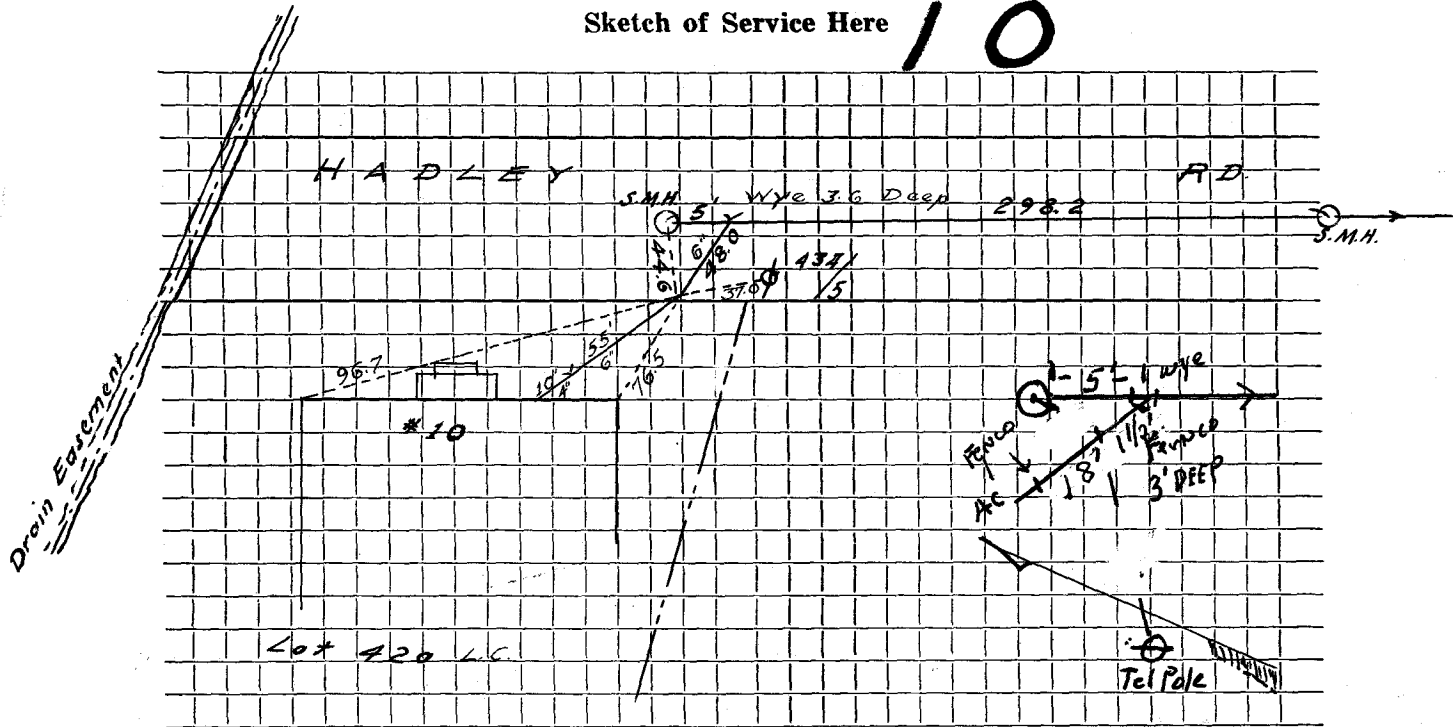

Connection made in ..... Street. Work completed .....

Remarks: **8123-90** REPAIR INST. (Roots coming in service beyond curb box in lawn 1/2 PIPE  
 18' ~~11/2"~~ PUC 2 Fences Jim McLaughlin Pipe AT WYE IS LEVEL  
 WATER SERVICE Under Fence by EDGE of RD