

Service No.

Name Harold C. Willson

Address 2 Hadley Road

Location Lot #416 Sta. 0+66L

Size of Main

Size

Kind of Pipe J.M.Lucente Permit #A193

Location


Repair—Renewal—New Service

Date	Material	Amount	Total	Date	Amount
5-7-66	<del>55' 6" Transit pipe</del>				
35'	6" TRANSITE			5-7-66	
10'	4" C.I. Pipe			20'	6" TRANSITE

DATE \_\_\_\_\_

TOWN OF LEXINGTON — BOARD OF PUBLIC WORKS  
SEWER DIVISION

Sketch of Service Here **2**

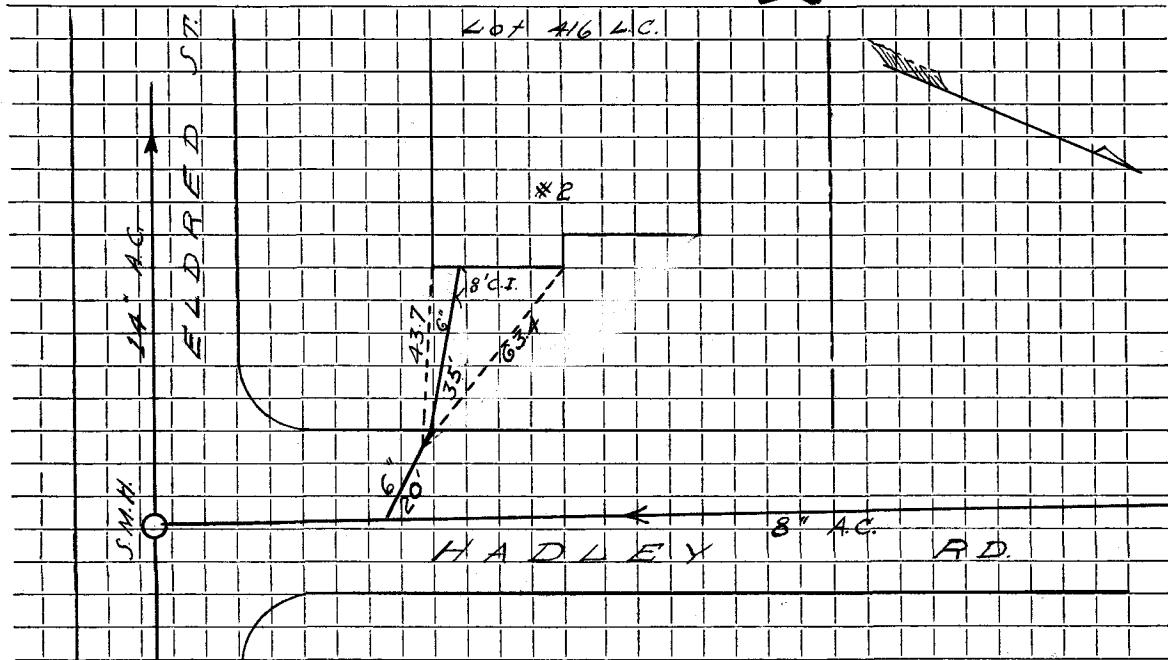

Connection made in ..... Street. Work completed .....

Remarks: .....  
.....  
.....